

MONROE  
Ø 29  
12-8-70

MISSISSIPPI  
 BOARD OF WATER COMMISSIONERS  
 416 North State Street  
 Jackson, Mississippi 39201

**CODED**

WATER WELL DRILLERS LOG

12-8 1970 Landon Horns Well Monroe  
 date well completed firm name county well located

LANDOWNER: Mrs. Richard Dumas  
Route 4, Apt. 3  
Aberdeen, Miss.  
 (mailing address)

Description of formations encountered	from	to
<u>Surface sand</u>	<u>0</u>	<u>25</u>
<u>Red clay</u>	<u>25</u>	<u>240</u>
<u>Sand</u>	<u>240</u>	<u>380</u>
<u>Clay</u>	<u>380</u>	

WELL LOCATION:  
 sec. 12 T. 15 N. R. 6 E  
S  
1 1/2 miles SW of Aberdeen  
 (distance) (direction) (nearest town)

WELL PURPOSE: home  
 (home, irrigation, municipal, industrial)

- WELL COMPLETION DATA:
- (1) diameter (inches) 5
  - (2) total depth (feet) 380
  - (3) static water level (feet) 130 below top of ground.
  - (4) casing Steel, 34'5"  
 (material) (depth)
  - 5" If telescope see back.  
 (size)
  - (5) screen no  
 (length) (depth to top)
  - (size) (material)
  - (6) pump 3/4 5  
 (HP) (yield gpm)
  - Electric  
 (type power)
  - (7) electric log no  
 (yes or no)
  - (organization running log)
  - (8) how well bottom plugged Open

**CODED**


DEC 14 1970

DRILLERS REMARKS:

MISS. BD. OF  
 WATER COMMISSIONERS

If well telescopes please sketch and show depths.

GROUND LEVEL

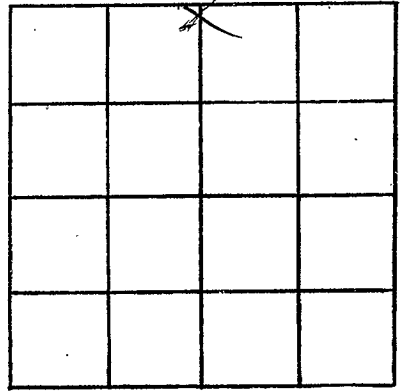

SECTION 12

Please indicate well location X.

ADDITIONAL INFORMATION

If more than one screen,  
show locations of each on sketch.