

MONROE  
030  
5-31-71

MISSISSIPPI  
BOARD OF WATER COMMISSIONERS  
416 North State Street  
Jackson, Mississippi 39201

CODED

WATER WELL DRILLERS LOG

Hendon-Roman Well & Supply, Inc.

P. O. Box 42

Monroe

5-31  
date well completed

1971

SHANNON, MISSISSIPPI 39488 county well located

LANDOWNER: Willie Blanchard

description of formations encountered

from to

Route 1

Surface clay

0 29

Prairie, Miss. 39456  
(mailing address)

Blue clay

29 260

Sand

260 400

Gravel

400

WELL LOCATION:

sec. 17 T. 15 N. R. 6 E  
S  
1 1/2 miles SW of Prairie  
(distance) (direction) (nearest town)

WELL PURPOSE: Home  
(home, irrigation, municipal, industrial)

WELL COMPLETION DATA:

- (1) diameter (inches) 5"
- (2) total depth (feet) 400'
- (3) static water level (feet) 113 below top of ground.
- (4) casing Steel 35' (material) (depth)  
5" (size) if telescope see back.
- (5) screen no (length) (depth to top).  
(size) (material)
- (6) pump 1/2 (HP) 5 (yield gpm)  
electric (type power)
- (7) electric log no (yes or no)  
(organization running log)
- (8) how well bottom plugged open

CODED


JUN 15 1971

DRILLERS REMARKS:

MISSISSIPPI  
BOARD OF WATER COMMISSIONERS  
JACKSON, MISSISSIPPI

If well telescopes please sketch and show depths.

GROUND LEVEL

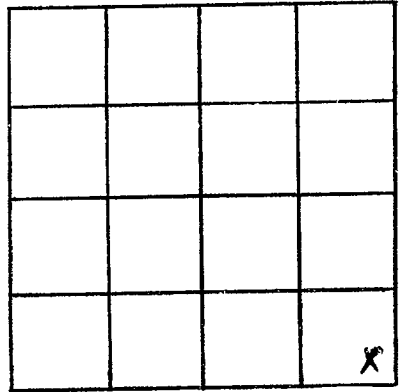

SECTION 12

Please indicate well location X.

ADDITIONAL INFORMATION

Lined area for additional information.

If more than one screen, show locations of each on sketch.