

Monroe
 0-31
 7-20-71

MISSISSIPPI
 BOARD OF WATER COMMISSIONERS
 416 North State Street
 Jackson, Mississippi 39201

CODED

WATER WELL DRILLERS LOG

~~W. H. Homan~~ Homan Well & Supply, Inc.

P. O. Box 42

Monroe

7-20 1971
 date well completed

BLANKEN, MISSISSIPPI 38903 county well located

LANDOWNER: John L. Grand
Route 1
Courtland, Ala. 35618
 (mailing address)

description of formations encountered	from	to
Surface sand & clay	0	35
Blue clay	35	202
Red Sand	202	340
Bottom	340	

WELL LOCATION:
 sec. 36 T. 15 N. R. 6E
1 miles SE of Milled
 (distance) (direction) (nearest town)

WELL PURPOSE: home
 (home, irrigation, municipal, industrial)

- WELL COMPLETION DATA:
- (1) diameter (inches) 5"
 - (2) total depth (feet) 340
 - (3) static water level (feet) 120 below
 top of ground.
 - (4) casing Steel, 40'
 (material) (depth)
5"
 (size) If telescope see back.
 - (5) screen 70,
 (length) (depth to top)
 (size) (material)
 - (6) pump 1/2, 10
 (HP) (yield gpm)
electric
 (type power)
 - (7) electric log no
 (yes or no)
 (organization running log)
 - (8) how well bottom plugged open

CODED


AUG 5 1971

MISS. BD. OF
 WATER COMMISSIONERS

DRILLERS REMARKS:

If well telescopes please sketch and show depths.

GROUND LEVEL

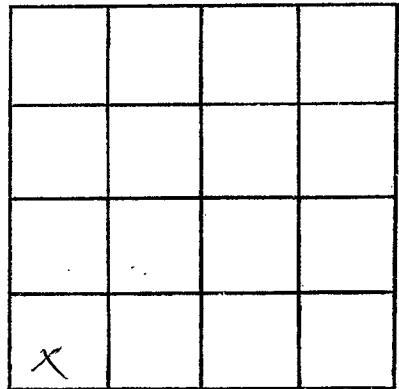

SECTION 36

Please indicate well location X.

ADDITIONAL INFORMATION

If more than one screen, show locations of each on sketch.