

MONROE
 36
 3-21-72

MISSISSIPPI
 BOARD OF WATER COMMISSIONERS
 416 North State Street
 Jackson, Mississippi 39201

CODED

WATER WELL DRILLERS LOG

3-21-1972 Herndon-Homan Well & Supply, Inc. Monroe
 date well completed Firm Name Box 44 county well located
 STANNON MISSISSIPPI 38808


LANDOWNER:
E.A. Watson
847 Grand West Blvd Mrs
 (mailing address)

description of formations encountered	from	to
<u>Surface clay</u>	<u>0</u>	<u>16</u>
<u>Blue clay</u>	<u>16</u>	<u>24</u>
<u>Sand</u>	<u>24</u>	<u>38</u>
<u>Gravel</u>	<u>38</u>	

WELL LOCATION:
 sec. 14 T 16 N R 6 E
1 miles SWS of Sturgis
 (distance) (direction) (nearest town)

WELL PURPOSE: Home
 (home, irrigation, municipal, industrial)

- WELL COMPLETION DATA:
- (1) diameter (inches) 5
 - (2) total depth (feet) 380
 - (3) static water level (feet) 144 below above top of ground.
 - (4) casing steel, 20'6"
 (material) (depth)
5 If telescope see back.
 (size)
 - (5) screen NO
 (length) (depth to top)
 (size) (material)
 - (6) pump 1/2 5
 (HP) (yield gpm)
electric
 (type power)
 - (7) electric log NO
 (yes or no)
 (organization running log)
 - (8) how well bottom plugged OK

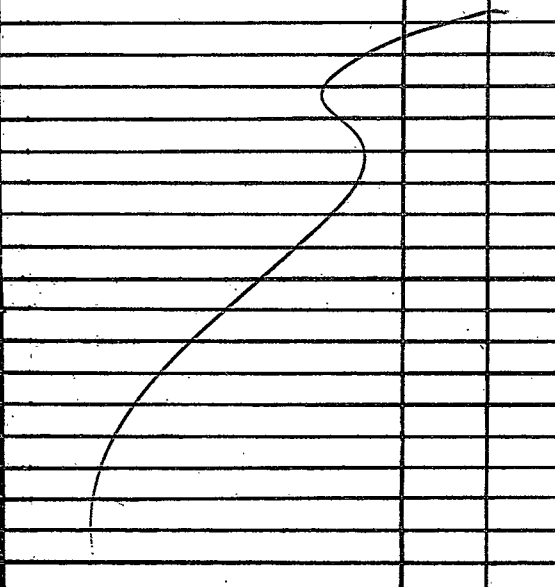

CODED


CODED
 APR 1972

DRILLERS REMARKS:

MISS. DE. OF
 WATER COMM.

If well telescopes please sketch and show depths.

GROUND LEVEL

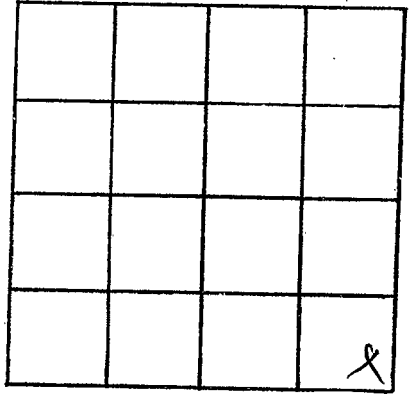

SECTION 14

Please indicate well location X.

ADDITIONAL INFORMATION

If more than one screen,
show locations of each on sketch.