

MONROE
 037
 4-27-72

MISSISSIPPI
 BOARD OF WATER COMMISSIONERS
 416 North State Street
 Jackson, Mississippi 39201

CODED

WATER WELL DRILLERS LOG

date well completed 4/27 1972 Herndon-Homan Well & Supply, Inc. Monroe
 firm name Box 42 county well located
SHANNON, MISSISSIPPI 38868

LANDOWNER:
Erickson Baud
Rt 1, Prairie, Miss.
 (mailing address)

description of formations encountered	from	to
<u>Suber clay</u>	<u>0</u>	<u>35</u>
<u>Blue clay</u>	<u>35</u>	<u>340</u>
<u>Sand</u>	<u>340</u>	<u>500</u>
<u>Bottom</u>	<u>500</u>	

WELL LOCATION:
 sec. 6 T. 15 N. R. 6 E.
274 miles W of Prarie
 (distance) (direction) (nearest town)

WELL PURPOSE:
 (home, irrigation, municipal, industrial)
Home

- WELL COMPLETION DATA:
- (1) diameter (inches) 5"
 - (2) total depth (feet) 500'
 - (3) static water level (feet) 96' below/above top of ground.
 - (4) casing Steel, 58' (material) (depth)
5 (size) If telescope see back.
 - (5) screen no (length) (depth to top)
 (size) (material)
 - (6) pump 1/2 (HP) 5 (yield gpm)
electric (type power)
 - (7) electric log NO (yes or no)
 (organization running log)
 - (8) how well bottom plugged open

CODED


MAY 12 1972

MISS. BD. OF
 WATER COMMISSIONERS

DRILLERS REMARKS:

If well telescopes please
sketch and show depths.

GROUND LEVEL

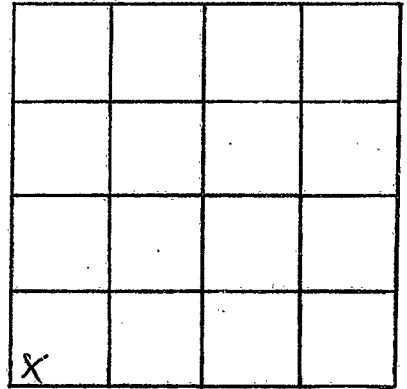

SECTION 6

Please indicate well location X.

ADDITIONAL INFORMATION

If more than one screen,
show locations of each on sketch.