

MONROE
038
3-30-72

MISSISSIPPI
 BOARD OF WATER COMMISSIONERS
 416 North State Street
 Jackson, Mississippi 39201

CODED

WATER WELL DRILLERS LOG

March 30 1972 Herndon Well & Supply Co. Monroe
 date well completed firm name county well located

LANDOWNER:	description of formations encountered	from	to
J. T. Somers 204 W. College Place Aberdeen, Miss. 39730 (mailing address)			
	Blue Rock	16	250
	Sand	250	440
WELL LOCATION:			
sec. 27 T15S N R 6E E S W			
1 1/2 miles N of Prairie (distance) (direction) (nearest town)			
WELL PURPOSE: (home, irrigation, municipal, industrial)			
WELL COMPLETION DATA:			
(1) diameter (inches) 5"	CODED		
(2) total depth (feet) 440			
(3) static water level (feet) 169 below above top of ground.			
(4) casing steel, 20 ft (material) (depth)			
5" if telescope see back. (size)			
(5) screen (length) (depth to top) (size) (material)			
(6) pump 3/4 10 gpm (HP) (yield gpm)			
elec (type power)			
(7) electric log no (yes or no) (organization running log)			
(8) how well bottom plugged open			


MAY 11 1972

DRILLERS REMARKS:

MISS. BD. OF
 WATER COMMISSIONERS

If well telescopes please sketch and show depths.

GROUND LEVEL

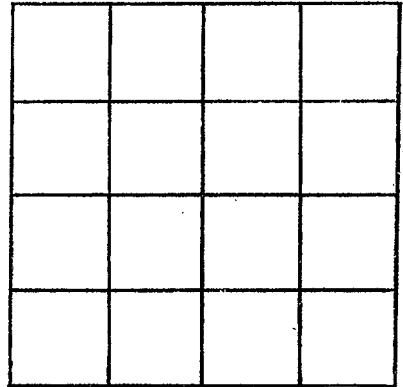

SECTION _____

Please indicate well location X.

ADDITIONAL INFORMATION

If more than one screen, show locations of each on sketch.