

MONROE
039
3-31-72

MISSISSIPPI
 BOARD OF WATER COMMISSIONERS
 416 North State Street
 Jackson, Mississippi 39201

CODED

WATER WELL DRILLERS LOG

March 31 1972 Herndon Well & Supply Co Monroe
 date well completed firm name county well located

LANDOWNER:
 Church of God & Christ
 c/o Fred D. Jamison
 Rt. 1 Box 200
 Prairie, Miss. 39756
 (mailing address)

description of formations encountered	from	to
	Red Clay	0
Blue Rock	20	200
Sand	200	340
340 Gumbo	340	350

WELL LOCATION:
 sec. 4 T16S N R. 6E E
 S Muldon
 1/2 miles West Junction
 (distance) (direction) (nearest town)

WELL PURPOSE: church
 (home, irrigation, municipal, industrial)

WELL COMPLETION DATA:

- (1) diameter (inches) 5"
- (2) total depth (feet) 350
- (3) static water level (feet) _____ below
 top of ground. above
- (4) casing steel 32 ft
 (material) (depth)
5" if telescope see back.
 (size)
- (5) screen _____ / _____
 (length) (depth to top)
 (size) (material)
- (6) pump none _____
 (HP) (yield gpm)
 (type power)
- (7) electric log no
 (yes or no)
 (organization running log)
- (8) how well bottom plugged open

CODED


MAY 11 1972

MISS. BD. OF
 WATER COMMISSIONERS

DRILLERS REMARKS:

If well telescopes please sketch and show depths.

GROUND LEVEL

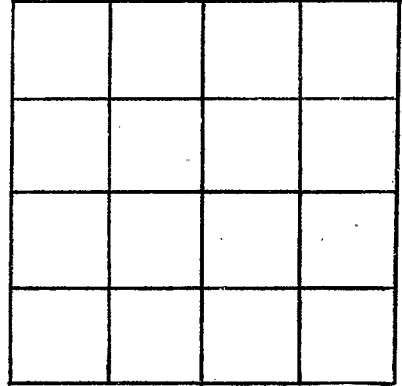

SECTION _____

Please indicate well location X.

ADDITIONAL INFORMATION

If more than one screen, show locations of each on sketch.