

MONROE

Ø 40

7-12-72

MISSISSIPPI
 BOARD OF WATER COMMISSIONERS
 416 North State Street
 Jackson, Mississippi 39201

CODED

WATER WELL DRILLERS LOG

July 12 1972
date well completed

J.W. Webb & Sons
firm name

Monroe
county well located

LANDOWNER: William Hill
RR #3 Box 269
West Point, Miss 39773
 (mailing address)

description of formations encountered	from	to
Sandy Clay Topsoil	0	30
blue marl	30	200
dark blue sand & shale	200	340

WELL LOCATION:
 sec. 8 T. 16 N R. 6 W
8 miles N of West Point
 (distance) (direction) (nearest town)

WELL PURPOSE: home
 (home, irrigation, municipal, industrial)

- WELL COMPLETION DATA:
- (1) diameter (inches) 4
 - (2) total depth (feet) 320
 - (3) static water level (feet) 60 ^{below} above top of ground.
 - (4) casing steel 38 ft
 (material) (depth)
4"
 (size) if telescope see back.
 - (5) screen None
 (length) (depth to top)
None
 (size) (material)
 - (6) pump 3/4 jet 6
 (HP) (yield gpm)
Elect
 (type power)
 - (7) electric log NO
 (yes or no)
- (organization running log)
- (8) how well bottom plugged open hole

CODED


OCT 13 1972

MISS. DE. OF AGRICULTURE

DRILLERS REMARKS: Extremely
hard rock 290-291 1/2 feet

If well telescopes please sketch and show depths.

GROUND LEVEL

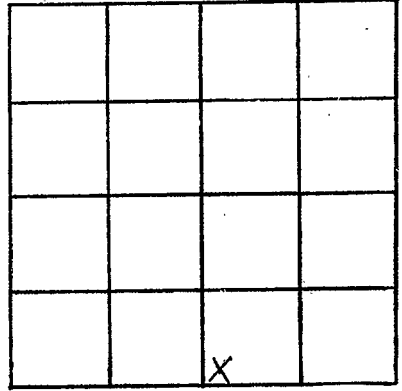

SECTION 8

Please indicate well location X.

ADDITIONAL INFORMATION

If more than one screen,
show locations of each on sketch.