

MISSISSIPPI
BOARD OF WATER COMMISSIONERS
416 North State Street
Jackson, Mississippi 39201

CODED

WATER WELL DRILLERS LOG

MONROE
041
7-24-72

July 24 19 72 J.W. Webb & Sons Inc. MONROE
date well completed firm name county well located

LANDOWNER: Willie B Cox
Rt #4 Box 316
Aberdeen, Miss. 39230
(mailing address)

WELL LOCATION:
sec. 15 T 15 N R. 6 E
S W
2 miles S of PRAIRIE
(distance) (direction) (nearest town)

description of formations encountered	from	to
<u>Black clay d' red clay</u>	<u>0</u>	<u>18</u>
<u>blue marl</u>	<u>18</u>	<u>180</u>
<u>Light to dark blue sand</u>	<u>180</u>	<u>330</u>
<u>blue marl.</u>	<u>330</u>	<u>340</u>

WELL PURPOSE: home
(home, irrigation, municipal, industrial)

- WELL COMPLETION DATA:
- (1) diameter (inches) 4
 - (2) total depth (feet) 340
 - (3) static water level (feet) 80 ^{below} above top of ground.
 - (4) casing steel 21 ft
(material) (depth)
4"
(size) if telescope see back.
 - (5) screen none
(length) (depth to top)
none
(size) (material)
 - (6) pump 1 Rod 3
(HP) (yield gpm)
Elect
(type power)
 - (7) electric log no
(yes or no)
X
(organization running log)
 - (8) how well bottom plugged open
note

CODED


OCT 18 1972

DRILLERS REMARKS: _____

MISS. DEP. OF
AGRICULTURE
LAND AND WATER

If well telescopes please sketch and show depths.

GROUND LEVEL

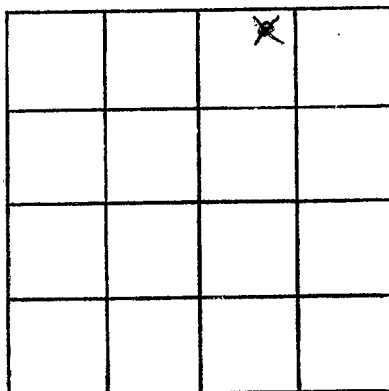

SECTION 15

Please indicate well location X.

ADDITIONAL INFORMATION

If more than one screen, show locations of each on sketch.