

MONROE
 42
 10-2-72

MISSISSIPPI
 BOARD OF WATER COMMISSIONERS
 416 North State Street
 Jackson, Mississippi 39201

WATER WELL DRILLERS' LOG

CODED

10/2 1972 date well completed
 Herman Homan Well & Supply, Inc. firm name
 SHANNON MISSISSIPPI 38168
 MONROE county well located

LANDOWNER:
 LAVVY JACKSON
 Rt 9 Aberdeen, MISS.
 (mailing address)

description of formations encountered	from	to
Sandy clay	0	21
Clay	21	200
Sand	200	340
Bottom	340	

WELL LOCATION:
 sec. 13 T 15 N R 6 E
 S W
 2 1/2 miles SE of Prairie
 (distance) (direction) (nearest town)

WELL PURPOSE:
 Home
 (home, irrigation, municipal, industrial)

- WELL COMPLETION DATA:
- (1) diameter (inches) 4"
 - (2) total depth (feet) 340'
 - (3) static water level (feet) 139' below top of ground.
 - (4) casing steel 25' (material) (depth)
 5' if telescope see back. (size)
 - (5) screen ND (length) (depth to top)
 (size) (material)
 - (6) pump 1/2 (HP) 5 (yield gpm)
 electric (type power)
 - (7) electric log ND (yes or no)
 - (organization running log)
 - (8) how well bottom plugged open

CODED


NOV 5 1972

DRILLERS REMARKS:

Miss. Bd. of
 WATER COMMISSIONERS

If well telescopes please sketch and show depths.

GROUND LEVEL

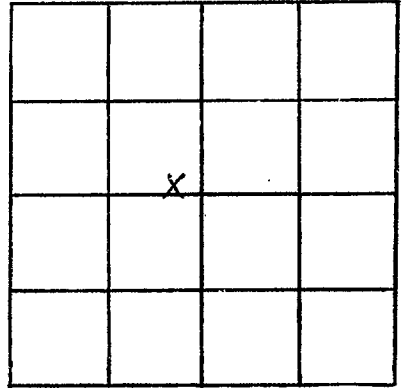

SECTION 12

Please indicate well location X.

ADDITIONAL INFORMATION

If more than one screen, show locations of each on sketch.