

*Fred Morgan (contractor)*

**MONROE**  
**043**  
**2-15-73**



**HERMAN ECHOLS,**  
Pump & Well Service  
Starkville, Miss:  
Phone: 323-5111

**MISSISSIPPI**  
**BOARD OF WATER COMMISSIONERS**  
416 North State Street

Jackson, Mississippi 39201



**HERMAN ECHOLS,**  
Pump & Well Service  
**WATER WELL DRILLERS LOG**

**CODED**

Starkville, Miss:  
Phone: 323-5111  
firm name

*Morgan*  
county well located

*2/15*  
date well completed

19*73*

LANDOWNER:	description of formations encountered	from	to
<i>West Point, Miss</i> (mailing address)	<i>Clay &amp; Sand</i>	<i>0</i>	<i>30</i>
	<i>Rich &amp; Arch</i>	<i>30</i>	<i>200</i>
	<i>Sand</i>	<i>30</i>	<i>200</i>
<b>WELL LOCATION:</b>			
<i>Sec. 12 T. 46 N. R. 6 E.</i> <i>South East corner Morgan Co.</i> <i>6 miles NE of West Point</i> (distance) (direction) (nearest town)			
<b>WELL PURPOSE:</b> (home, irrigation, municipal, industrial)			
<b>WELL COMPLETION DATA:</b>			
(1) diameter (inches) <i>5"</i>			
(2) total depth (feet) <i>200</i>			
(3) static water level (feet) <i>50</i> below above top of ground.			
(4) casing <i>30</i> , <i>5"</i> (material) (depth)			
(size) if telescope see back.			
(5) screen <i>—</i> <i>—</i> (length) (depth to top)			
(size) (material)			
(6) pump <i>3/4</i> <i>10 GPM</i> (HP) (yield gpm)			
<i>C. Carter</i> (type power)			
(7) electric log (yes or no) <i>—</i>			
(organization running log) <i>—</i>			
(8) how well bottom plugged <i>—</i>			
<b>DRILLERS REMARKS:</b>			


**CODED**

*MISS. 2 17 1973*

*MISS. 2 17 1973*

If well telescopes please sketch and show depths.

GROUND LEVEL

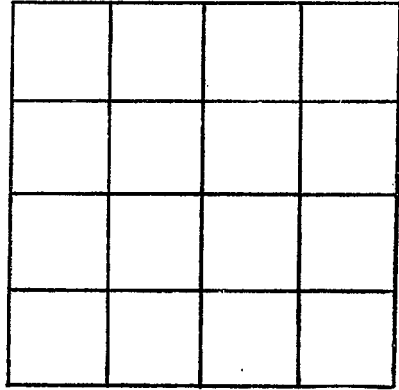

SECTION \_\_\_\_\_

Please indicate well location X.

ADDITIONAL INFORMATION

A series of horizontal lines for recording additional information, starting below the 'ADDITIONAL INFORMATION' header and extending to the bottom of the page.

If more than one screen, show locations of each on sketch.