

CODED

MISSISSIPPI
BOARD OF WATER COMMISSIONERS
416 North State Street
Jackson, Mississippi 39201

WATER WELL DRILLERS LOG

MONROE
CLAY

MONROE
044
5-27-73

May 27 1973 J.W. Webb & Sons date well completed firm name county well located

LANDOWNER: Fortenberry
Fortenberry Drilling Co.
Natchez, Miss.
(mailing address)

description of formations encountered	from	to
	topsoil	0
blue marl	18	230
light to dark blue sand	230	460

WELL LOCATION:
sec. 8 T. 16 N R. 6 E
1 1/2 miles N of STRONG
(distance) (direction) (nearest town)

WELL PURPOSE: irrigation
(home, irrigation, municipal, industrial)

- WELL COMPLETION DATA:
- (1) diameter (inches) 4"
 - (2) total depth (feet) 460 ft
 - (3) static water level (feet) 80' below above top of ground
 - (4) casing steel 21 ft
(material) (depth)
4" if telescope see back.
(size)
 - (5) screen _____
(length) (depth to top)
(size) (material)
 - (6) pump _____
(HP) (yield gpm)
(type power)
 - (7) electric log NO
(yes or no)
(organization running log)
 - (8) how well bottom plugged open hole

CODED


DRILLERS REMARKS:

JUN 11 1973

MISC. OR. OR.
WATER COMMISSIONERS

If well telescopes please sketch and show depths.

GROUND LEVEL

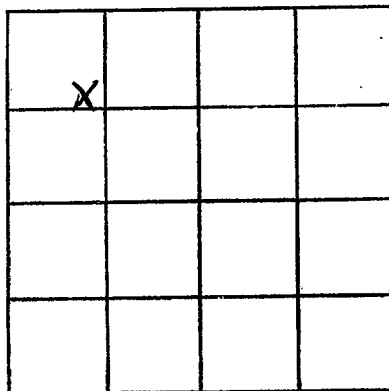

SECTION 8

Please indicate well location X.

ADDITIONAL INFORMATION

If more than one screen, show locations of each on sketch.