

MONROE
 45
 5-19-73

MISSISSIPPI
 BOARD OF WATER COMMISSIONERS
 416 North State Street
 Jackson, Mississippi 39201

CODED

WATER WELL DRILLERS LOG

May 19 19 73 J.W. Webb & Sons Monroe
 date well completed firm name county well located

LANDOWNER: ~~Tommy Blanchard~~
 Tommy Blanchard

description of formations encountered	from	to
topsoil	0	18
blue marl	18	280
dark blue sand	220	460

PRAIRIE, Miss
 (mailing address)

WELL LOCATION:
 sec. 6 T. 16 N R. 60 W
 15 miles SW of PRAIRIE
 (distance) (direction) (nearest town)

WELL PURPOSE: none
 (home, irrigation, municipal, industrial)

- WELL COMPLETION DATA:
- (1) diameter (inches) 4"
 - (2) total depth (feet) 460
 - (3) static water level (feet) 25 below top of ground
 - (4) casing steel 2 1/2" (material) (depth)
 4" (size) if telescope see back.
 - (5) screen (length) (depth to top)
 (size) (material)
 - (6) pump 1 1/2 HP 6 (type power) (yield gpm)
 elect
 - (7) electric log NO (yes or no)
 (organization running log)
 - (8) how well bottom plugged open hole


CODED

DRILLERS REMARKS:

VII 1973

If well telescopes please sketch and show depths.

GROUND LEVEL

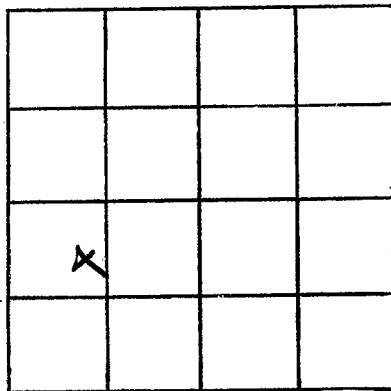

SECTION 6e

Please indicate well location X.

ADDITIONAL INFORMATION

If more than one screen, show locations of each on sketch.