

MISSISSIPPI
BOARD OF WATER COMMISSIONERS
416 North State Street
Jackson, Mississippi 39201

CODED

WATER WELL DRILLERS LOG

MONROE
046
12-4-72

Dec 4 1972 J.W. Webb & Sons Monroe
date well completed firm name county well located

LANDOWNER: <u>Walter C. Mobley</u>	description of formations encountered	from	to
<u>Abredeen, Miss</u> (mailing address)	<u>top soil of red sandy clay</u>	<u>0</u>	<u>15</u>
	<u>gray black sand</u>	<u>15</u>	<u>40</u>
	<u>blue sand</u>	<u>40</u>	<u>110</u>
WELL LOCATION: sec. <u>2</u> T. <u>16</u> N R. <u>10E</u> <u>W</u>	<u>blue marl</u>	<u>110</u>	<u>130</u>
<u>15</u> miles <u>N.E.</u> of <u>West Point</u> (distance) (direction) (nearest town)	<u>blue sand</u>	<u>130</u>	<u>265</u>
WELL PURPOSE: <u>home</u> (home, irrigation, municipal, industrial)			
WELL COMPLETION DATA: (1) diameter (inches) <u>4"</u>			
(2) total depth (feet) <u>265 ft</u>			
(3) static water level (feet) <u>40</u> <u>below</u> top of ground.			
(4) casing <u>steel</u> , <u>270 ft</u> (material) (depth) <u>4"</u> (size) if telescope see back.			
(5) screen _____ (length) (depth to top). _____ (size) (material)			
(6) pump <u>1/2</u> <u>6</u> (HP) (yield gpm) <u>elect</u> (type power)			
(7) electric log <u>NO</u> (yes or no) _____ (organization running log)			
(8) how well bottom plugged <u>open</u> <u>hole</u>			

CODED


JUN 11 1973

MISS. Bd. of
WATER COMMISSIONERS

DRILLERS REMARKS:

If well telescopes please sketch and show depths.

GROUND LEVEL

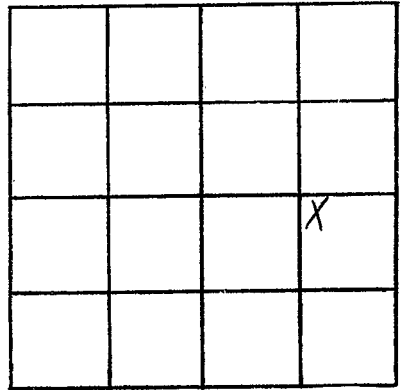

SECTION 2

Please indicate well location X.

ADDITIONAL INFORMATION

If more than one screen, show locations of each on sketch.