

MONROE
 47
 11-15-72

MISSISSIPPI
 BOARD OF WATER COMMISSIONERS
 416 North State Street
 Jackson, Mississippi 39201

CODED

WATER WELL DRILLERS LOG

Nov 15 1972 J. W. Webb & Sons Monroe
 date well completed firm name county well located


LANDOWNER: <u>Jessie Ewing</u>	description of formations encountered	from	to
<u>PRaire, Miss</u> (mailing address)	<u>top soil, red & white clay</u> <u>blue marl</u> <u>blue gray sand</u>	0 30 220	30 220 405
WELL LOCATION: sec. <u>19</u> T. <u>15</u> N. R. <u>6</u> E. <u>10</u> miles <u>South</u> of <u>PRaire</u> (distance) (direction) (nearest town)			
WELL PURPOSE: <u>home</u> (home, irrigation, municipal, industrial)			
WELL COMPLETION DATA:			
(1) diameter (inches) <u>4"</u>			
(2) total depth (feet) <u>22 405 ft</u>			
(3) static water level (feet) <u>100</u> <u>below</u> above top of ground.			
(4) casing <u>steel</u> , <u>42 ft</u> (material) (depth) <u>4"</u> If telescope see back. (size)			
(5) screen _____ (length) (depth to top) (size) (material)			
(6) pump <u>1/2 sub</u> <u>8</u> (HP) (yield gpm) <u>elect</u> (type power)			
(7) electric log <u>NO</u> (yes or no) (organization running log)			
(8) how well bottom plugged <u>open</u> <u>hole</u>			
DRILLERS REMARKS:			

CODED

NOV 15 1972

If well telescopes please sketch and show depths.

GROUND LEVEL

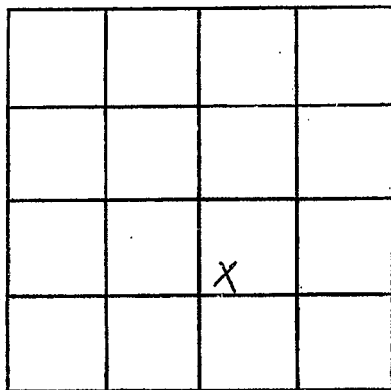

SECTION 19

Please indicate well location X.

ADDITIONAL INFORMATION

If more than one screen,
show locations of each on sketch.