

MONROE  
 48  
 9-25-72

MISSISSIPPI  
 BOARD OF WATER COMMISSIONERS  
 416 North State Street  
 Jackson, Mississippi 39201

**CODED**

WATER WELL DRILLERS LOG

Sept 25 1972 J.W. Webb & Sons MONROE  
 date well completed firm name county well located

LANDOWNER: Webb Evans, Jr.  
 593 Mayhew St.  
 West Point, Miss 39773  
 (mailing address)

description of formations encountered	from	to
topsoil & white clay	0	18
blue marl	18	240
blue sand	240	328

WELL LOCATION:  
 sec. 8 T. 16 N R. 6 E  
 1.0 miles north of West Point  
 (distance) (direction) (nearest town)

WELL PURPOSE: home  
 (home, irrigation, municipal, industrial)

- WELL COMPLETION DATA:
- (1) diameter (inches) 4"
  - (2) total depth (feet) 420 ft
  - (3) static water level (feet) 60 <sup>below</sup> above top of ground.
  - (4) casing steel, 21 ft (material), (depth)  
 4" (size) if telescope see back.
  - (5) screen NONE (length) (depth to top)  
 (size) (material)
  - (6) pump 3/4 jet, 6 (HP), (yield gpm).  
 ELECT (type power)
  - (7) electric log NO (yes or no)  
 (organization running log)
  - (8) how well bottom plugged open hole

**CODED**


SEP 19 1972

DRILLERS REMARKS: HARD ROCK  
 329-330 ft

R

If well telescopes please sketch and show depths.

GROUND LEVEL

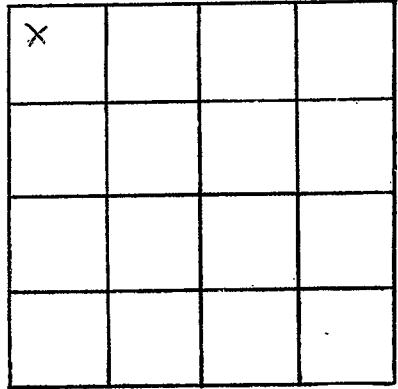

SECTION 2

Please indicate well location X.

ADDITIONAL INFORMATION

If more than one screen, show locations of each on sketch.