

MONROE  
 049  
 5-22-73

MISSISSIPPI  
 BOARD OF WATER COMMISSIONERS  
 416 North State Street  
 Jackson, Mississippi 39201

**CODED**

WATER WELL DRILLERS LOG

5-22-1973 date well completed *Herman Homan Well & Supply, Inc.* P. H. Homan  
 Monroe county well located

LANDOWNER: *Robert Clayton*  
*PARSON Job.*  
*Mr. A. B. Aboudeed, Miss.*  
 (mailing address)

description of formations encountered	from	to
<i>Surface clay</i>	<i>0</i>	<i>16</i>
<i>Shale clay</i>	<i>16</i>	<i>220</i>
<i>Sand</i>	<i>220</i>	<i>360</i>
<i>Bottom</i>	<i>360</i>	

WELL LOCATION:  
 sec. *19* T. *15* N. R. *6* E.  
*3* miles *SW* of *Prarie*  
 (distance) (direction) (nearest town)

WELL PURPOSE: *Home*  
 (home, irrigation, municipal, industrial)

- WELL COMPLETION DATA:
- (1) diameter (inches) *5"*
  - (2) total depth (feet) *360'*
  - (3) static water level (feet) *75'* below top of ground.
  - (4) casing *steel*, *21'*,  
 (material) (depth)  
*5"* if telescope see back.  
 (size)
  - (5) screen *no*,  
 (length) (depth to top)  
 (size) (material)
  - (6) pump *1/2* (HP) *5* (yield gpm)  
*electric*  
 (type power)
  - (7) electric log *no*  
 (yes or no)  
 (organization running log)
  - (8) how well bottom plugged *open*


**CODED**

DRILLERS REMARKS:

*JUN 14 1973*

If well telescopes please sketch and show depths.

GROUND LEVEL

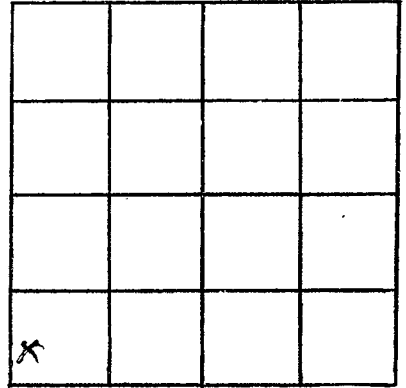

SECTION 19

Please indicate well location X.

ADDITIONAL INFORMATION

If more than one screen,  
show locations of each on sketch.