

MONROE

\$ 50

7-23-73

MISSISSIPPI  
 BOARD OF WATER COMMISSIONERS  
 416 North State Street  
 Jackson, Mississippi 39201

**CODED**

WATER WELL DRILLERS LOG

6-74  
date well completed

19 2P Herman Homan Well & Supply, Inc.

Monroe  
county well located

P.O. Box 42

SHANNON, MISSISSIPPI 38668

LANDOWNER:

David Jones Jr.  
Rt 1 Box 107, Prairie Miss  
(mailing address)

description of formations encountered

	from	to
Surface sand & clay	0	38
Blue clay	38	240
Sand	240	360
Both	360	

WELL LOCATION:

sec 30 T 15 N R 6 E  
3 1/2 miles SW of Prairie  
(distance) (direction) (nearest town)

WELL PURPOSE: Home  
(home, irrigation, municipal, industrial)

WELL COMPLETION DATA:

- (1) diameter (inches) 5"
- (2) total depth (feet) 360'
- (3) static water level (feet) 68' below top of ground.
- (4) casing Steel, 42' 2" (depth)  
5" (size) if telescope see back.
- (5) screen 10 (length), (depth to top)  
(size) (material)
- (6) pump 1/2 (HP), 5 (yield gpm)  
electric (type power)
- (7) electric log No (yes or no)  
(organization running log)
- (8) how well bottom plugged Open


**CODED**

JUL 18 1973

DRILLERS REMARKS:

If well telescopes please sketch and show depths.

GROUND LEVEL

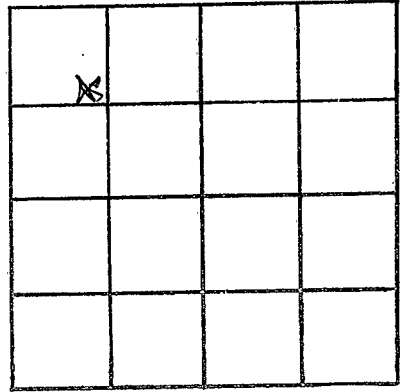

SECTION 30

Please indicate well location X.

ADDITIONAL INFORMATION

If more than one screen, show locations of each on sketch.