

MONROE

Ø 51

7-23-73

MISSISSIPPI
 BOARD OF WATER COMMISSIONERS
 416 North State Street
 Jackson, Mississippi 39201

CODED

WATER WELL DRILLERS LOG

Herman Homan Well & Supply, Inc.

P. O. Box 42

6-26 19 73
date well completed

SHANNON, MISSISSIPPI 38668

Monroe
county well located

LANDOWNER: L.C. Cooke
Jessie Hampton
West Point, Miss.
 (mailing address)

Description of formations encountered

from to

Surface sand & clay	0	28
Blue clay	28	290
Sand	290	360
Both	360	

WELL LOCATION:

sec. 13 T. 16 N R. 6 E
 S W
1 1/2 miles SW of Stonewall
 (distance) (direction) (nearest town)

WELL PURPOSE: home
 (home, irrigation, municipal, industrial)

WELL COMPLETION DATA:

- diameter (inches) 5"
- total depth (feet) 360
- static water level (feet) 190 below above top of ground.
- casing steel, 3"
 (material) (depth)
5" if telescope see back.
 (size)
- screen no,
 (length) (depth to top)
 (size) (material)
- pump 1 1/2, 5
 (HP) (yield gpm)
electric
 (type power)
- electric log no
 (yes or no)
 (organization running log)
- how well bottom plugged open


CODED

DRILLERS REMARKS:

JUL 10 1973

If well telescopes please sketch and show depths.

GROUND LEVEL

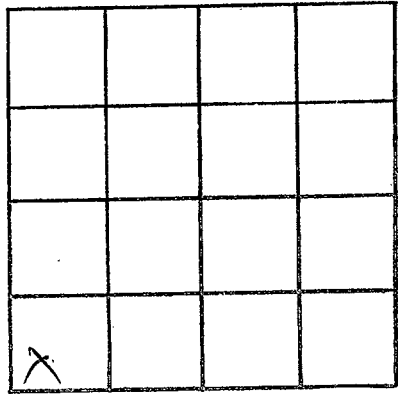

SECTION 13

Please indicate well location X.

ADDITIONAL INFORMATION

If more than one screen, show locations of each on sketch.