

MONROE
 52
 7-23-73

MISSISSIPPI
 BOARD OF WATER COMMISSIONERS
 416 North State Street
 Jackson, Mississippi 39201

CODED

WATER WELL DRILLERS LOG

7/6 1973 Herman Homan Well & Supply, Inc.
 date well completed P.O. Box 42
 CHANNON, MISSISSIPPI 38668
 county well located Monroe

LANDOWNER:

Marenthia Cunningham
 Rt 1 Box 51, Prairie, Miss
 (mailing address)

description of formations encountered

Surface sand & clay
 Blue clay
 Sand
 Bottom

from to

0 28
 28 260
 260 700
 700

WELL LOCATION:

sec. 17-15 N R-6 E
 S W of PRAIRIE
 (distance) miles (direction) (nearest town)

WELL PURPOSE: flow
 (home, irrigation, municipal, industrial)

WELL COMPLETION DATA:

- (1) diameter (inches) 5"
- (2) total depth (feet) 400'
- (3) static water level (feet) 98' below top of ground.
- (4) casing: steel, 3 1/2" (material) (depth)
5" (size) if telescope see back.
- (5) screen 50' (length) (depth to top)
 (size) (material)
- (6) pump 1/2 (HP) 5 (yield gpm)
electric (type power)
- (7) electric log no (yes or no)
 (organization running log)
- (8) how well bottom plugged spec


CODED

DRILLERS REMARKS:

JUL 10 1973

If well telescopes please sketch and show depths.

GROUND LEVEL

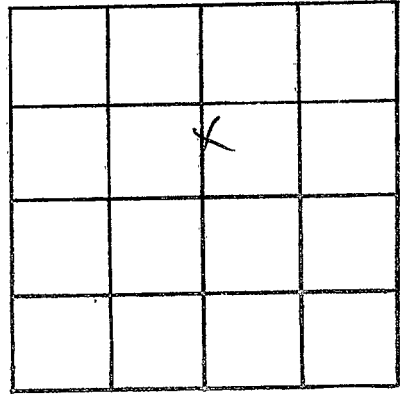

SECTION 19

Please indicate well location X.

ADDITIONAL INFORMATION

If more than one screen,
show locations of each on sketch.