

MONROE
Ø 53
7-30-73

MISSISSIPPI
BOARD OF WATER COMMISSIONERS
416 North State Street
Jackson, Mississippi 39201

WATER WELL DRILLERS LOG

CODED

Herman Homan Well & Supply, Inc.

7/30 19 73
date well completed

P.O. Box 42
firm name

Monroe
county well located

SHANNON, MISSISSIPPI 38668

LANDOWNER: L.C. Cook

Eddie Ford

Rt 1, Prairie Miss.
(mailing address)

WELL LOCATION:

sec. 30 T 15 N R 6 E
3 1/2 miles SW of Prairie
(distance) (direction) (nearest town)

WELL PURPOSE:
(home, irrigation, municipal, industrial)

WELL COMPLETION DATA:

- (1) diameter (inches) 5"
- (2) total depth (feet) 380'
- (3) static water level (feet) 80' below top of ground.
- (4) casing steel 32' 4" (material), (depth)
5" (size) if telescope see back.
- (5) screen NO (length), (depth to top)
(size) (material)
- (6) pump 1/2 (HP) 5 (yield gpm)
Electric (type power)
- (7) electric log NO (yes or no)
(organization running log)
- (8) how well bottom plugged open

Description of formations encountered

from to

Surface sand
& clay
Blue clay
Sand
Bottom

0 18
18 240
240 380
380


CODED

DRILLERS REMARKS:

SEP 6/1973

If well telescopes please sketch and show depths.

GROUND LEVEL

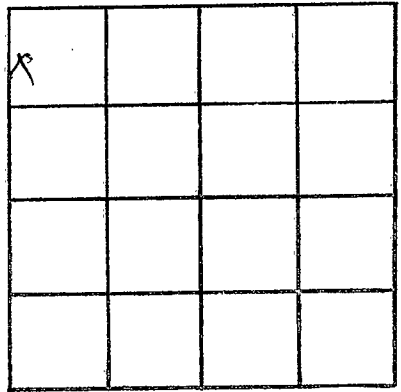

SECTION 30

Please indicate well location X.

ADDITIONAL INFORMATION

If more than one screen, show locations of each on sketch.