

MONROE
 1854
 9-19-73

MISSISSIPPI
 BOARD OF WATER COMMISSIONERS
 416 North State Street
 Jackson, Mississippi 39201

CODED

WATER WELL DRILLERS LOG

Herman Homan Well & Supply, Inc.
 P. O. Box 42

9-19-73
 date well completed

SHANNON, MISSISSIPPI 38468

MONROE
 county well located

LANDOWNER: I.C. Cook
 Ben Kelly
 Rt 1, Roxie, Miss.
 (mailing address)

description of formations encountered	from	to
	surface clay	0
blue clay	16	180
sand	180	320
bottom	320	

WELL LOCATION:
 sec. 5 T. 16 N. R. 6 E
 S W
 1 1/2 miles SW of Muldon
 (distance) (direction) (nearest town)

WELL PURPOSE: Home
 (home, irrigation, municipal, industrial)

- WELL COMPLETION DATA:
- (1) diameter (inches) 5"
 - (2) total depth (feet) 320'
 - (3) static water level (feet) 122' below above top of ground.
 - (4) casing steel, 21 1/2" (material), (depth)
 5' (size) if telescope see back.
 - (5) screen ND (length), (depth to top)
 (size) (material)
 - (6) pump 1/2 (HP), 5 (yield gpm)
 electric (type power)
 - (7) electric log ND (yes or no)
 (organization running log)
 - (8) how well bottom plugged open


CODED

DRILLERS REMARKS:

NOV 18 1973

If well telescopes please sketch and show depths.

GROUND LEVEL

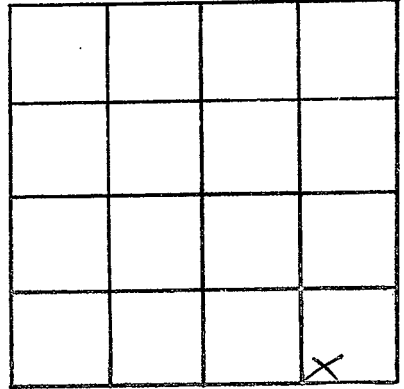

SECTION SC

Please indicate well location X.

ADDITIONAL INFORMATION

If more than one screen, show locations of each on sketch.