

MONROE  
 Ø55  
 10-22-73

MISSISSIPPI  
 BOARD OF WATER COMMISSIONERS  
 416 North State Street  
 Jackson, Mississippi 39201

WATER WELL DRILLERS LOG

CODED

Herman Homan Well & Supply

P. O. Box 42

SHANNON, MISSISSIPPI 38868

Monroe county well located

10/22 1973  
 date well completed

LANDOWNER:

Will Hatten  
 Rt 4 Aberdeen, Miss  
 (mailing address)

description of formations encountered

	from	to
Surface clay	0	3'
Blue clay	3'	20'
Sand	20'	34'
Bottom	34'	

WELL LOCATION:

sec. 13-15 N R-6 E  
 S  
 2 miles SE of Prairie  
 (distance) (direction) (nearest town)

WELL PURPOSE:

Home  
 (home, irrigation, municipal, industrial)

WELL COMPLETION DATA:

- (1) diameter (inches) 5 1/2"
- (2) total depth (feet) 34'
- (3) static water level (feet) 115' below top of ground.
- (4) casing steel, 4 1/2" (material), 42' 5" (depth)  
 5" (size) if telescope see back.
- (5) screen no (length), (depth to top)  
 (size) (material)
- (6) pump 3/4 (HP), 3 (yield gpm)  
 electric (type power)
- (7) electric log no (yes or no)  
 (organization running log)
- (8) how well bottom plugged open

CODED



DRILLERS REMARKS:

NOV 25 1973

Large RD  
 WATER

If well telescopes please sketch and show depths.

GROUND LEVEL

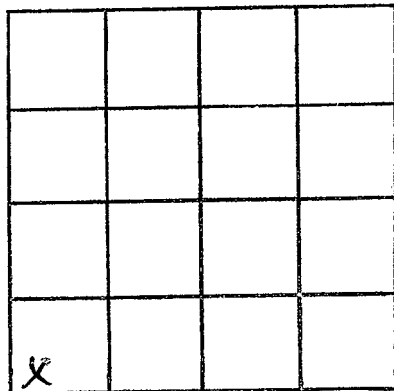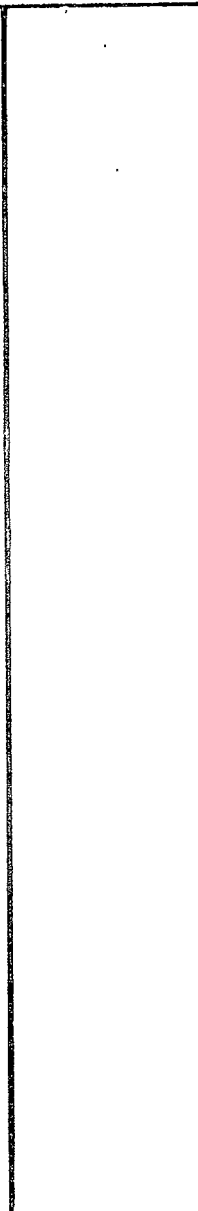

SECTION 13

Please indicate well location X.

ADDITIONAL INFORMATION

Lined area for additional information.

If more than one screen, show locations of each on sketch.