

MONROE
#57
5-1-74

MISSISSIPPI
BOARD OF WATER COMMISSIONERS
416 North State Street
Jackson, Mississippi 39201

CODED

WATER WELL DRILLERS LOG

5-1
date well completed

1974 Herman Homan Well & Supply, Inc.
P.O. Box 42
SHANNON, MISSISSIPPI 38968

MONROE
county well located

LANDOWNER:

description of formations
encountered

from to

Rosie Hesperbottom
#3 West Point Ave.
(mailing address)

Surface sand 0 16
clay 16 220
Sand 220 360
Bottom 360

WELL LOCATION:

sec. 7 T. 16 N. R. 6 E.
3 miles SW of Muldon
(distance) (direction) (nearest town)

WELL PURPOSE: Home
(home, irrigation, municipal, industrial)

WELL COMPLETION DATA:

- (1) diameter (inches) 5 1/4
- (2) total depth (feet) 360
- (3) static water level (feet) 27 below top of ground
- (4) casing steel, 21 1/2" (material) (depth)
5 1/2" (size) if telescope see back.
- (5) screen 10" (length) (depth to top)
(size) (material)
- (6) pump 1/2 (HP) (yield gpm)
elect. (type power)
- (7) electric log (yes or no)
- (organization running log)
- (8) how well bottom plugged open

CODED


MAY 1 1974

DRILLERS REMARKS:

MISS. BD. OF WATER

If well telescopes please sketch and show depths.

GROUND LEVEL

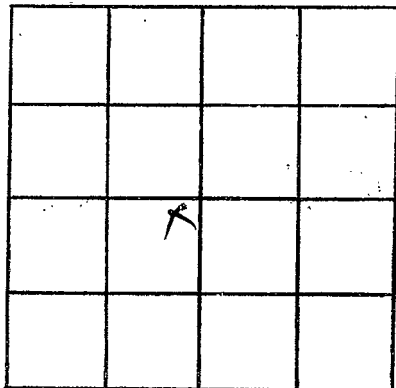

SECTION 7

Please indicate well location X.

ADDITIONAL INFORMATION

If more than one screen,
show locations of each on sketch.