

MONROE
 058
 8-1-74

MISSISSIPPI
 BOARD OF WATER COMMISSIONERS
 416 North State Street
 Jackson, Mississippi 39201

CODED

WATER WELL DRILLERS LOG

8/1 1974 Herman Homan Well & Supply, Inc. Monroe
 date well completed from Order 42 county well located
 SHANNON MISSISSIPPI 39169

LANDOWNER:	description of formations encountered	from	to
John Thomas	Surface sand	0	16
At 1 Prairie, Miss	+ clay		
(mailing address)	Blue clay	16	220
	Sand	220	360
	Bottom	360	
CODED			
RECEIVED			
AUG - 8 1974			
MISS. Bd. OF WATER COMMISSIONERS			

WELL LOCATION:
 sec. 19 T. 15 N. R. 6 E.
 S W
 1 1/2 miles SE of Prairie
 (distance) (direction) (nearest town)

WELL PURPOSE: Home
 (home, irrigation, municipal, industrial)

WELL COMPLETION DATA:

(1) diameter (inches) 5 1/4

(2) total depth (feet) 360

(3) static water level (feet) 162' below top of ground.

(4) casing steel, 20' 10" (material) (depth)
 5" If telescope see back. (size)

(5) screen NO (length) (depth to top)
 (size) (material)

(6) pump 3/4 5 (HP) (yield gpm)
 electric (type power)


(7) electric log NO (yes or no)
 (organization running log)

(8) how well bottom plugged open

DRILLERS REMARKS:

If well telescopes please sketch and show depths.

GROUND LEVEL

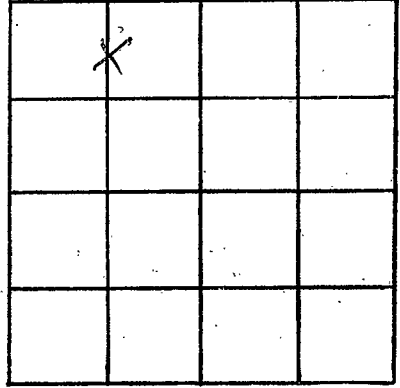

SECTION 14

Please indicate well location X.

ADDITIONAL INFORMATION

Lined area for additional information.

If more than one screen, show locations of each on sketch.