

MONROE
 059
 3-22-75

MISSISSIPPI
 BOARD OF WATER COMMISSIONERS
 416 North State Street
 Jackson, Mississippi 39201

WATER WELL DRILLERS LOG

Monroe

3/22 1975 Herman Homan Well & Supply, Inc.
 date well completed firm, Box 42

county well located

SHANNON, MISSISSIPPI 39088

LANDOWNER:

J. A. McMillan
 Rt 1 Prairie, Miss
 (mailing address)

description of formations encountered

from to

Surface sand 0 15
 Blue clay 15 260
 Sand 260 400
 Bottom (400)

WELL LOCATION:

sec. 21 T 15 N R 6 E
 2 1/2 miles S of PRAIRIE
 (distance) (direction) (nearest town)

WELL PURPOSE: Home
 (home, irrigation, municipal, industrial)

WELL COMPLETION DATA:


- (1) diameter (inches) 5"
- (2) total depth (feet) 400'
- (3) static water level (feet) 95' below top of ground.
- (4) casing steel, 19'4" (material) (depth)
 5" (size) if telescope see back.
- (5) screen NO (length) (depth to top)
 (size) (material)
- (6) pump NO (HP) (yield gpm)
 (type power)
- (7) electric log NO (yes or no)
 (organization running log)
- (8) how well bottom plugged open

DRILLERS REMARKS:

APR 23 1975
 MISS. BD. OF WATER COMMISSIONERS

If well telescopes please sketch and show depths.

GROUND LEVEL

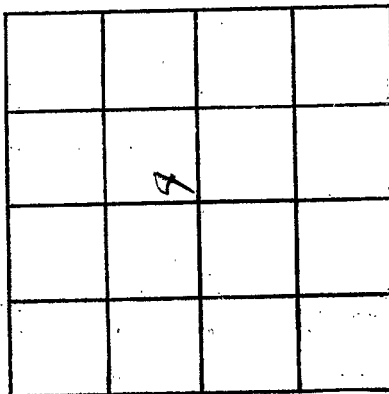

SECTION 21

Please indicate well location X.

ADDITIONAL INFORMATION

If more than one screen, show locations of each on sketch.