

Monroe
 060
 '6-18-75

MISSISSIPPI
 BOARD OF WATER COMMISSIONERS
 416 North State Street
 Jackson, Mississippi 39201

CODED

WATER WELL DRILLERS LOG

6/18
 date well completed

1975

Herman Homan Well & Supply, Inc.

firm name 42

Monroe
 county well located

CHANNON, MISSISSIPPI 38568


LANDOWNER:	description of formations encountered	from	to
Robert Sykes, Jr. Rt 3, West Point Miss (mailing address)			
WELL LOCATION: sec. 18 T 16 N R 6 E 13E 9 miles SW of Malden (distance) (direction) (nearest town)			
WELL PURPOSE: (home, irrigation, municipal, industrial)			
WELL COMPLETION DATA:			
(1) diameter (inches) 4"			
(2) total depth (feet) 380'			
(3) static water level (feet) 67' below top of ground.			
(4) casing steel, 21' (material) (depth) 44 (size) if telescope see back.			
(5) screen no (length) (depth to top) (size) (material)			
(6) pump 1 (HP) 5 (yield gpm) electric (type power)			
(7) electric log no (yes or no)			
(organization running log)			
(8) how well bottom plugged open			
DRILLERS REMARKS:			

CODED

RECEIVED
 JUL 2 1975

If well telescopes please sketch and show depths.

GROUND LEVEL

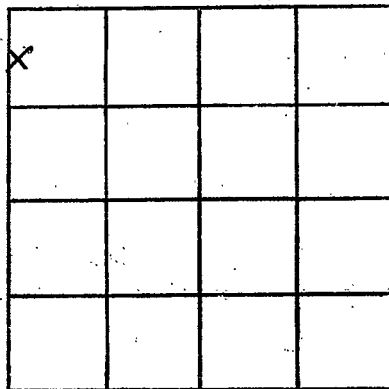

SECTION 18

Please indicate well location X.

ADDITIONAL INFORMATION

If more than one screen,
show locations of each on sketch.