

MONROE
 061
 12/30/77

MISSISSIPPI
 BOARD OF WATER COMMISSIONERS
 416 North State Street
 Jackson, Mississippi 39201

WATER WELL DRILLERS LOG

CODED
 Monroe
 county well located

12/30/77 19 GRINKER Drilling Service
 date well completed firm name

LANDOWNER: Par Exploration
 J. T. Evans Jr. #1

description of formations encountered	from	to
Hard Rock + Chalk	0	150
Streaked	151	178
Chalk	179	331
Streaked	332	352
Chalk + Rock	353	500
Sand	501	520
Chalk	521	525

(mailing address)
 WELL LOCATION:
 sec 5 T 15 N R 6 E
 1500' S of 1500' W of NE 1/4 of Aberdeen
 (distance) miles (direction) of (nearest town)

WELL PURPOSE:
 (home, irrigation, municipal, industrial)

WELL COMPLETION DATA:
 (1) diameter (inches) 3"
 (2) total depth (feet) 525
 (3) static water level (feet) 150 below top of ground above
 (4) casing STEEL 357' (material) (depth)
 24 (size) If telescope see back.
 (5) screen (length) (depth to top)
 (size) (material)
 (6) pump 50 (HP) (yield gpm)
 AC (type power)
 (7) electric log NO (yes or no)
 (organization running log)

(8) how well bottom plugged open ended


DRILLERS REMARKS:

RECEIVED
 FEB 10 1978

MISS. BD. OF WATER COMMISSIONERS

If well telescopes please sketch and show depths.

GROUND LEVEL

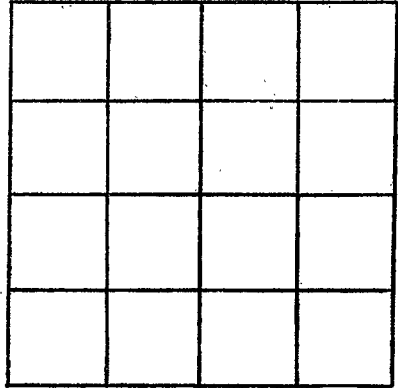

SECTION _____

Please indicate well location X.

ADDITIONAL INFORMATION

If more than one screen,
show locations of each on sketch.