

MONROE
 Ø 62
 1-27-78

MISSISSIPPI
 BOARD OF WATER COMMISSIONERS CODED
 416 North State Street
 Jackson, Mississippi 39201

WATER WELL DRILLERS LOG

MONROE
~~MISSISSIPPI~~

1-27 1978 W.J. REEVES & SON
 date well completed firm name county well located


LANDOWNER: PRAIRIE LIVESTOCK	description of formations encountered	from	to
P.O. BOX 203			
WEST POINT (mailing address)	BLUE CLAY	16	260
WELL LOCATION: sec. 18 T. 16 S. R. 6 E	" SAND	260	276
7 miles NO of WEST POINT	" CLAY	276	305
(distance) (direction) (nearest town)	BLUE SAND & CLAY	305	400
WELL PURPOSE: FARM (home, irrigation, municipal, industrial)	CODED		
WELL COMPLETION DATA:			
(1) diameter (inches) 6			
(2) total depth (feet) 400			
(3) static water-level (feet) 115 below above top of ground.			
(4) casing PVC, 40 (material) (depth)			
6 (size) if telescope see back.			
(5) screen NONE (length) (depth to top)			
(size) (material)			
(6) pump 5 30 (HP) (yield gpm)			
ELECT (type power)			
(7) electric log NO (yes or no)			
(organization running log)			
(8) how well bottom plugged OPEN			
DRILLERS REMARKS:			

RECEIVED
 APR 18 1978

MISS. BD. OF WATER COMM

If well telescopes please sketch and show depths.

GROUND LEVEL

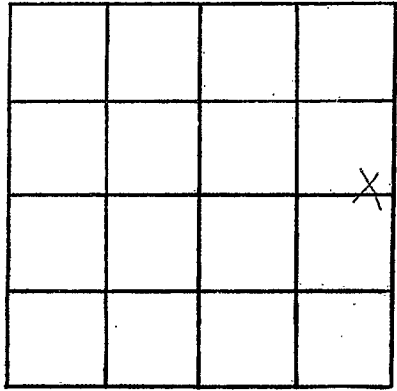

SECTION 18

Please indicate well location X.

ADDITIONAL INFORMATION

If more than one screen,
show locations of each on sketch.