

MONROE

0-63

4-67

MISSISSIPPI BOARD OF WATER COMMISSIONERS

WATER WELL DRILLERS LOG

Merndon-Homan Well & Supply, Inc.

Date: 4-29, 1967, Driller: P. O. Box 42, County: Monroe, STANTON, MISSISSIPPI 39088 (Where well is located)

(When well drilled)

(Where well is located)

(1) Owner of Land: Richard Rowe (Name)

contractor, Prairie, Miss. (Address)

(2) Location: SW 1/4, SE 1/4, Sec. 32 T15R6E

2 miles N. of Mableton (distance, direction, Nearest Town)

(3) Topography: flat (Flat)

(4) Purpose of Well: Home (Domestic Irrigation, Municipal, Industrial, Other)

Description & Color of Materials Sand, Clay, Red Clay, Shell, etc.

Thick-ness Feet

Depth Feet

surface sand & clay	0	18
Blue clay	18	220
sand	220	340
Bottom	340	

Information upon completion of well:

(1) Diameter 5 inches.

(2) Total Depth 340 feet.

(3) Water Level 85 feet below top of ground.

(4) Cased to 22' 6", Size 5.4

(5) Screen: Size None, Length

(6) Were any formations sealed against pollution? yes, no.

If YES depth of formation 20'


Why surface sand

Drillers Remarks:

Yield in gpm:

Size pump: By Other

Type power:

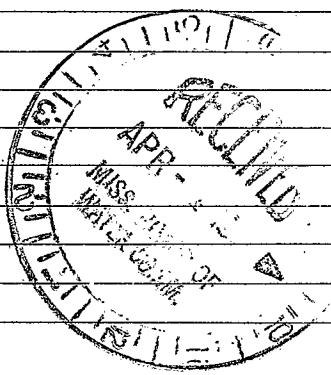

Retain this copy for your office files.

