

MISSISSIPPI DEPARTMENT OF NATURAL RESOURCES

Bureau of Land and Water Resources

Southport Mall

P.O. Box 10631

Jackson, Mississippi 39209

WATER WELL DRILLERS LOG

CODED

Griner Drilling Service, Inc.

Monroe

MONROE
Ø 64
8-22-81

date well completed

firm name

county well located

LANDOWNER:
Ensearch Exploration
1230 River Bend
Suite 136
Dallas, TX (mailing address) 75247

description of formations encountered	from	to
<i>clay</i>	<i>0</i>	<i>294</i>
<i>clay, rock, sand</i>	<i>294</i>	<i>450</i>

WELL LOCATION: *2000' N + 1500' W*
#1 sec. 16 T. 15 R. 2E of
FOUTZ Muldon Field
(distance) (direction) (nearest town)

WELL PURPOSE: *oil field*
(home, irrigation, municipal, industrial)
supply

CODED

WELL COMPLETION DATA:

- (1) diameter (inches) *3"*
- (2) total depth (feet) *450'*
- (3) static water level (feet) *—* below top of ground.
- (4) casing *steel*, *294'*
(material) (depth)
3"
(size) if telescope see back.
- (5) screen *—* *—*
(length) (depth to top)
open ended
(size) (material)
- (6) pump *—* *75*
(HP) (yield gpm)
AC
(type power)
- (7) electric log *—*
(yes or no)
(organization running log)

DEPT. OF NATURAL RESOURCES
BUREAU OF LAND & WATER RESOURCES

AUG 26 1981


RECEIVED

(8) how well bottom plugged *Orange*
peel

DRILLERS REMARKS:

If well telescopes please sketch and show depths.


GROUND LEVEL

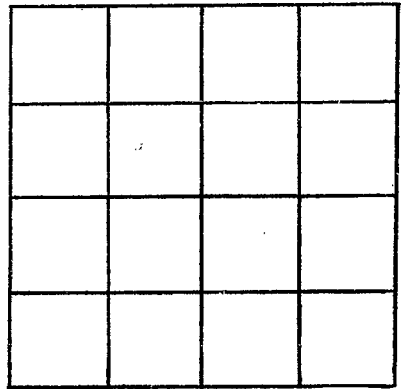

SECTION _____

Please indicate well location X.

ADDITIONAL INFORMATION

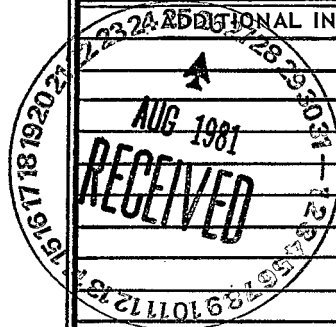

If more than one screen, show locations of each on sketch.