

	State Well Report	······				
County:_ MONROE	Part 1 – Driller's Log	For Office Use Only:				
	Mississippi Department of Environmental Qua	lity Aquifer:				
Permit #:	Office of Land and Water Resources					
Driller: FARKS of FARKS	P.O. Box 10631	Well #: <u>Q - 100</u>				
	Jackson, MS 39289-0631	L. S. Elevation:				
Date drilling completed: _7/3//07	(601)961-5210					
	(601)354-6938 (fax)	E-log #:				
State Law requires that this repor Department at the above address Information on Well O (Landowner if borehole is not fo	r a water well)	well or borehole. or Borehole Location				
Owner Name LHT RAN	ch Launde. <u>35 15</u>	Latitude: <u>33°45 '56</u> " Longitude: <u>88°41 ' 37</u> '				
Qo Z	Method of Lat/Long (cir	Method of Lat/Long (circle one): Conventional Survey,				
Mailing Address: $P.0.50 \times 188$						
Houlka, MS 38850 USGS quad, Hand-held GPS, Survey-grade GPS						
SE 1/ SE 1/ Sec 20 Twn 155 Rng 6E						
0:+	SNW NE					
	- Miles nl	of West Town				
Telephone No. (66) -447-0	347 <u>10</u> willes <u>10</u>	UI MEST FOINT, MS				
7/10/20	Well / Borehole Data ling completed: 7/3/67 Hole depth: 45	· · · · ·				
Date drilling started:Date dril	hing completed:HHole depth:	D Hole diameter: 8				
Location of the source of any surface water used for drilling:						
Logs run (circle all applicable): No log run Name of organization running log(s)-	Electric Gamma Ray Density Sonic Neutro	on Other:				
Purpose of borehole (check one): Water We	ll Geotechnical/Geological Investigation Gr	ound Source Heat Pump				
	urveyOther (describe) o water well construction, skip the remainder of th	is block				
Purpose of Well (check one): Home	ustrial Public Supply Irrigation Fish Cult	ture Other:				
If a flowing well, method of flow regulation: Valve Other (describe)						
Static Water Level:feet abo	Static Water Level:feet above or below (circle one) land surface Date measured:8/2/07					
Method of Measurement (circle one) steel tape electric tape air line other:						
Well depth: 450 Well grouted to a depth of 50 feet Type of grout (circle one): Neat Cement Bentonite Mix						
	diameter:inches Type of casing					
Screen length: <u>70</u> feet Screen	diameter: inches Type of screen	e PVC				
Screen slot size:	Setting depth: From <u>380</u> feet to	450 feet				
Type of completion (circle all applicable)	Gravel packed Underreamed Telescoped O	pen hole Natural Development				
	Other (describe):					
Top of lap pipe or reduction in casing:	feet. If telescoped or more than one s	screen, describe on next page				
		Form: OLWR-SWR-1A				
		RECEIVED				

•

AUG 27 2007 BY: OLWR

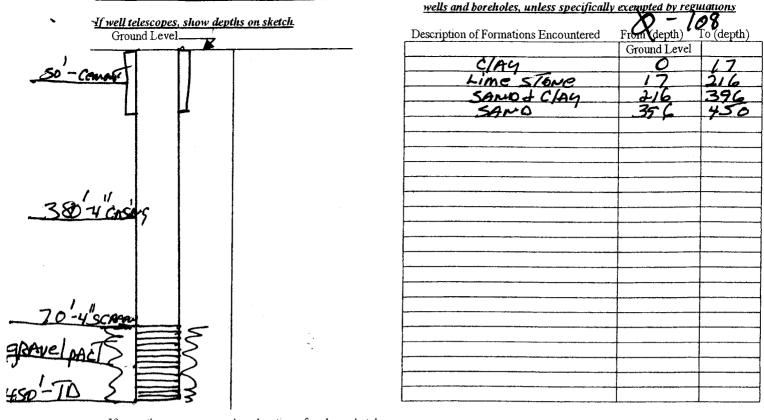

If more than one screen, show location of each on sketch

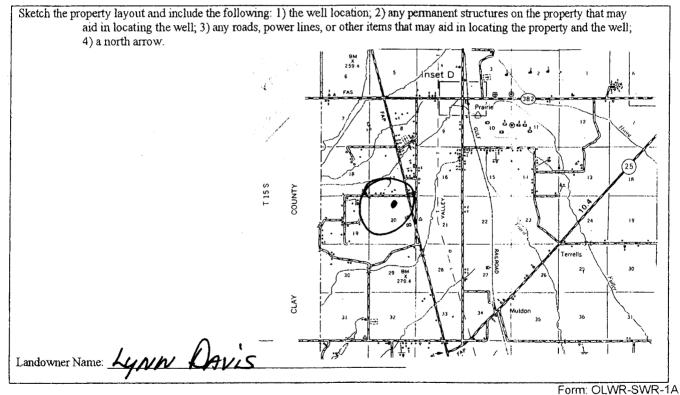

I certify that the well/borehole was drilled, constructed, and completed in accordance with all applicable requirements of the Mississippi Department of Environmental Quality and the Mississippi Department of Health regulations, if applicable, and state

laws 8/20/07 0-414 ARK 9a Date

Signature of Licensee RECEIVED

AUG 27 2007

BY: OLWR

Print Name of Responsible Licensee and License No.

STATE WELL REPORT					
County: MowRoe Permit #: Driller: Parks + Parks Date completed: 2/3/67 Copy information from block on Part 1 This part of the report must be completed and report must be attached and both parts file Well Owner Information Owner Name: Lynn Drvis Mailing Address: LHT Repuct	Pump Installer Mississippi Departme Office of Land P.O. Jackson, I (601 (601)35 by a licensed water well ad with the Department of ion	nt the above address within 30 of We Latitude:	lays of well completion. ll Location _ Longitude: ne): Conventional Survey,		
F.O Ko X 88 Houlky, MS City State Telephone No. (66) 447 - 03	Zip Code	SE 4 SE 4 Sec] Distance Direction	GPS_, Survey-grade GPS_ T_ <i>LSS_</i> R_ <i>G_E</i> Nearest Town f_ <i>West_Point,ms</i>		
Pump Type Circle one			wer Type ircle one		
Air Lift Jet	Submersible	Diesel Engine Gasolin	e Engine Natural Gas		
Bucket Piston	Turbine	Electric Motor Hand	Tractor PTO		
Centrifugal Rotary	Flowing Well	Windmill Other ((specify):		
Other (specify): Date Pump Installed: 8/7/0 Rated Pump Capacity: 50	7 Gallons Per Minute	Horse Power Rating of Motor Setting Depth:	feet		
Pump Test Data Date Well Tested: 8/3/07 Static Water Level (A): 77 Feet Below Land Surface Pumping Water Level (B): 125 Feet Below Land Surface		Method of Measuring Water Level Circle one Air Line Electric Measuring Line Steel Tape Other (specify):			
Drawdown [(B) – (A)]: <u>46</u> Feet Below Land Surface Test Pumping Rate: <u>50</u> Gallons Per Minute Duration of Pump Test (minimum 4 hours): <u>46</u> hours		For flowing well, measured shut in head:feet Well yieldedGPM with a drawdown offeet afterhours of pumping			
I HEREBY/CERTIFY that the above statemed A Statemed Franks Print Name of Pump Installer and License No	5-414	f my knowledge: Signature of Pump In	staller Form: OLWR-SWR-1B		

AUG 27 2007 BY: OLWR