

MONROE

MISSISSIPPI BOARD OF WATER COMMISSIONERS

WATER WELL DRILLERS LOG

HERNDON WELL & SUPPLY CO.

0300

Date: Sept 1, 1961, Driller: P. O. BOX 42 County MONROE
SHANNON, MISSISSIPPI

(1) Owner of Land: <u>Jesse Perry</u> (Name)	Description & Color of Materials Sand, Clay, Red Clay, Shell, etc.	Thick- ness Feet	Depth Feet
<u>Box 3 Aberdeen, Miss.</u> (Address)	<u>Surface sand & clay</u>		<u>0</u>
(2) Location: <u>1/4, 1/4, Sec 36 T. 153 R. 64</u> <u>3</u> miles <u>NW</u> of <u>Stamps</u> (distance) (direction) (Nearest Town)	<u>Blue sand</u>		<u>20</u>
(3) Topography: <u>Flat</u> (Hilly) (Flat) (Level)	<u>sand</u>		<u>250</u>
(4) Purpose of Well: <u>Domestic</u> (Domestic Irrigation Municipal, Industrial, Other)	<u>Bottom</u>		<u>320</u>


Information upon completion of well:

- (1) Diameter 4 inches.
- (2) Total Depth 320 feet.
- (3) Water Level 20 feet below top of ground.
- (4) Cased to 23', Size 4"
- (5) Screen: Size , Length
- (6) Were any formations sealed against pollution?
 yes, no.

If YES depth of formation 20

Why Surface & sand

Drillers Remarks: _____

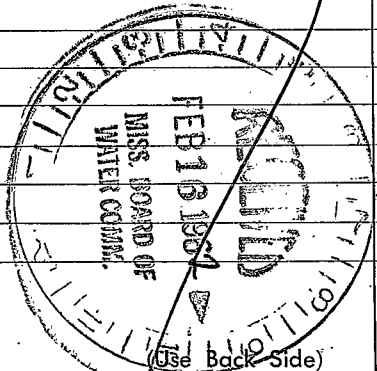

Well No.

