

WATER WELL DRILLERS LOG

0301

5-4-61

HERNDON WELL & SUPPLY CO.

Date: May 4, 1961, Driller: P. O. BOX 42 County Monroe SHANNON, MISSISSIPPI

(1) Owner of Land: John Busby  
(Name)  
At Ardmore, Miss.  
(Address)

(2) Location: 1/4, 1/4, Sec. 1 T. 16 S R. 6 E  
2 miles N.W., of Stony  
(distance) (direction) (Nearest Town)

(3) Topography: Flat  
(Hilly) (Flat) (Level)

(4) Purpose of Well: Home use  
(Domestic Irrigation  
Municipal, Industrial, Other)

Description & Color of Materials Sand, Clay, Red Clay, Shell, etc.	Thick- ness Feet	Depth Feet
<u>Surface Sand</u>		<u>0</u>
<u>&amp; clay</u>		
<u>Blue Rock</u>		<u>28</u>
<u>Sand</u>		<u>200</u>
<u>Bottom</u>		<u>320</u>

Information upon completion of well:

(1) Diameter 4 inches.

(2) Total Depth 320 feet.

(3) Water Level 90 feet below top of ground.

(4) Cased to 31 1/2", Size 4"


(5) Screen: Size         , Length         

(6) Were any formations sealed against pollution?  
 yes,  no.

If YES depth of formation 28'

Why Surface & sand

Drillers Remarks:         

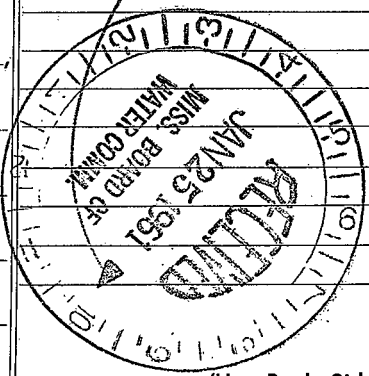

(Use Back Side)

Well No.

