

WATER WELL DRILLERS LOG

HERNDON WELL & SUPPLY CO.

Date: Oct 6, 1962, Driller: P. O. BOX 42 County: Monroe

SHANNON, MISSISSIPPI

(1) Owner of Land:	Description & Color of Materials Sand, Clay, Red Clay, Shell, etc.	Thick- ness Feet	Depth Feet
J.C. Gelling (Name) Rt 4 Aberdeen, Miss. (Address)	sand & clay		0
(2) Location: 1/4, 1/4, Sec 26 T 155 R 6E 3 1/2 miles SE Prairie, of Aberdeen (distance), (direction), (Nearest Town)	Blue Bank		15
(3) Topography: Flat (Hilly) (Flat) (Level)	Sand		162
(4) Purpose of Well: Domestic (Domestic Irrigation Municipal, Industrial, Other)	Bottom		280


Information upon completion of well:

- (1) Diameter 4 inches.
- (2) Total Depth 280 feet.
- (3) Water Level 90 feet below top of ground.
- (4) Cased to 18' 4", Size 4"
- (5) Screen: Size —, Length —
- (6) Were any formations sealed against pollution?
yes, no.

If YES depth of formation 15'

Why surface & sand

Drillers Remarks:

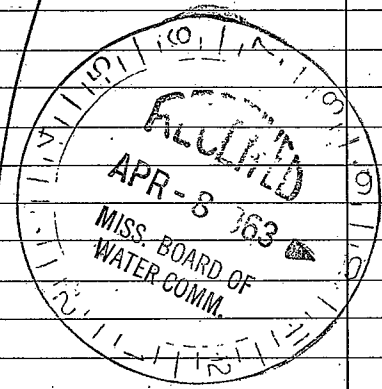

(Use Back Side)

Well No.

