

MONROE
 O 2001
 11-62

WATER WELL DRILLERS LOG

Date: Nov 14, 1962, Driller: Corrigan-Roman Well & Supply, Inc. County: Monroe

P. O. Box 42
 (Name)
 SHANNON, MISSISSIPPI 38868

(1) Owner of Land: Jack Perry
 (Name)
PT 4 Aberdeen, Miss
 (Address)

(2) Location: NE 1/4, NE 1/4, Sec. 1 T165R6E
2 miles SE, of Araldoon
 (distance) (direction) (Nearest Town)

(3) Topography: Flat
 (Hilly) (Flat) (Level)

(4) Purpose of Well: Farm
 (Domestic Irrigation
 Municipal, Industrial, Other)

Description & Color of Materials Sand, Clay, Red Clay, Shell, etc.	Thick- ness Feet	Depth Feet
<u>Surface clay</u>	<u>0</u>	<u>18</u>
<u>Blue clay</u>	<u>18</u>	<u>220</u>
<u>Sand</u>	<u>920</u>	<u>340</u>
<u>Bottom</u>	<u>340</u>	

Information upon completion of well:

(1) Diameter 6 inches.

(2) Total Depth 340 feet.

(3) Water Level 70' feet below top of ground.

(4) Cased to 21', Size 6"


(5) Screen: Size None, Length _____.

(6) Were any formations sealed against pollution?
 yes, _____ no.

If YES depth of formation 18'

Why Surface & Sand

Drillers Remarks: _____

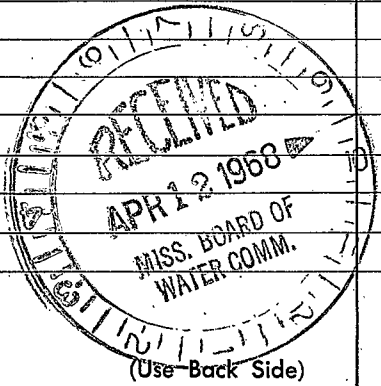

Well No. _____

