

MONROE
 O 2002
 11-62

MISSISSIPPI
 BOARD OF WATER COMMISSIONERS
 416 North State Street
 Jackson, Mississippi 39201

WATER WELL DRILLERS LOG

N-14 1962 ~~Marston-Homan Well & Supply~~ Monroe
 date well completed firm name Box 42 county well located
 SHANNON, MISSISSIPPI 38868

LANDOWNER:
 Jake Perry
 Rt 4 Aberdeen
 (mailing address)


description of fomations encountered	from	to
surface clay	0	18
blue clay	18	22
sand	22	340
bottom	340	

WELL LOCATION:
 sec. 1 T. 16 N. R. 6 E.
 S #
 2 miles SE of Muldrow
 (distance) (direction) (nearest town)

WELL PURPOSE: Farm
 (home, irrigation, municipal, industrial)

- WELL COMPLETION DATA:
- diameter (inches) 6
 - total depth (feet) 340
 - static water level (feet) 80 below top of ground.
 - casing Steel, 21' (material) (depth)
 If telescope see back. (size)
 - screen none (length) (depth to top)
 (size) (material)
 - pump 1/2 (HP) 10 (yield gpm)
 electric (type power)
 - electric log no (yes or no)
 (organization running log)
 - how well bottom plugged open

DRILLERS REMARKS:

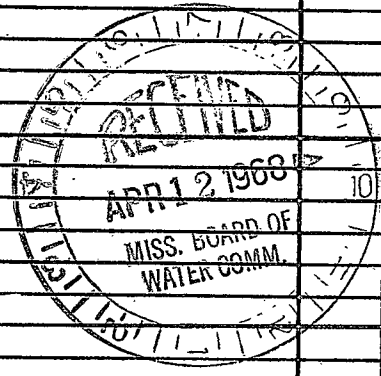

If well telescopes please sketch and show depths.

GROUND LEVEL

SECTION _____

Please indicate well location X.

ADDITIONAL INFORMATION

If more than one screen,
show locations of each on sketch.