

MONROE

0 2003
3-30-63

WATER WELL DRILLERS LOG

HERNDON WELL & SUPPLY CO.

Date: March 30, 1963, Driller: P.O. BOX 42 County Moore

SHANNON, MISSISSIPPI

(1) Owner of Land	Description & Color of Materials Sand, Clay, Red Clay, Shell, etc.	Thick- ness Feet	Depth Feet
(Name) <u>Mr. Frank White</u> (Address) <u>Aberdeen, Miss</u>	<u>surface sand & clay</u>		<u>0</u>
(2) Location: <u>1/4</u> , <u>1/4</u> , Sec. <u>28</u> T. <u>15</u> R. <u>6</u> <u>2 1/2</u> miles <u>S</u> of <u>Pravie</u> (distance) (direction) (Nearest Town)	<u>Blue rock</u> <u>sand</u>		<u>15</u> <u>220</u>
(3) Topography: <u>Level</u> (Hilly) (Flat) (Level)	<u>8</u>		
(4) Purpose of Well: <u>Domestic</u> (Domestic Irrigation Municipal, Industrial, Other)	<u>Bottom</u>		<u>368</u>


Information upon completion of well:

- (1) Diameter 4 inches.
- (2) Total Depth 368 feet.
- (3) Water Level 130 feet below top of ground.
- (4) Cased to 16' 7", Size 4"
- (5) Screen: Size _____, Length _____
- (6) Were any formations sealed against pollution?
 yes, _____ no.

If YES depth of formation 15

Why surface & sand

Drillers Remarks: _____

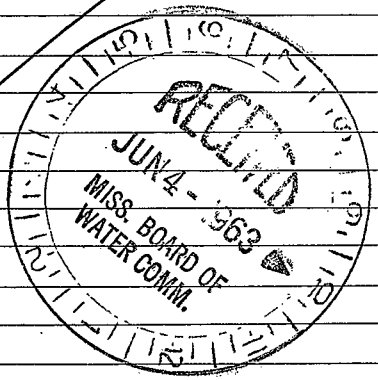

(Use Back Side)

Well No.

1942

1942

