

0 2004
5-2-04

WATER WELL DRILLERS LOG

Date: 5/2, 1904, Driller: HERNDON WELL & SUPPLY CO. County: Monroe
P. O. BOX #2
SHANNON, MISSISSIPPI

(1) Owner of Land:	(Name)	Description & Color of Materials Sand, Clay, Red Clay, Shell, etc.	Thick- ness Feet	Depth Feet
	Herbert Ewing			0
Prairie	(Address)	surface sand & clay		
(2) Location:	1/4, 1/4, Sec. 15 T. 15 R. 6 E	Blue sand		18
1 miles	SE	sand		220
(distance)	(direction)	to		
(3) Topography:	flat			
(4) Purpose of Well:	Domestic	Bottom		360
	(Domestic Irrigation Municipal, Industrial, Other)			


Information upon completion of well:

- (1) Diameter 4 inches.
- (2) Total Depth 360' feet.
- (3) Water Level 110 feet below top of ground.
- (4) Cased to 20", Size 4".
- (5) Screen: Size —, Length —.
- (6) Were any formations sealed against pollution?
 yes, no.

If YES depth of formation 18'

Why surface & sand

Drillers Remarks:

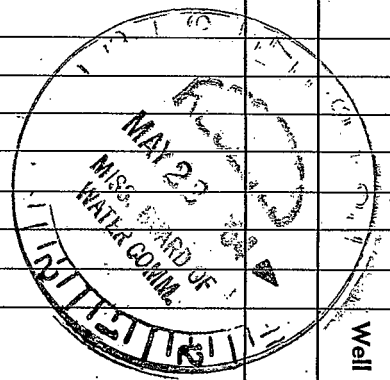

(Use Back Side)

Well No.

