

Monroe

0205

MISSISSIPPI BOARD OF WATER COMMISSIONERS

3-66

WATER WELL DRILLERS LOG

Herndon-Homan Well & Supply, Inc. *Monroe*

Date: *March 17, 1966*, Driller: *P. O. Box 42*, County: *Monroe*
(When well drilled) (Name) (Where well is located)

SHANNON, MISSISSIPPI 38888

(1) Owner of Land: *John Jackson*
(Name)

Description & Color of Materials
Sand, Clay, Red Clay, Shell, etc. Thickness Feet Depth Feet

West Point, Miss.
(Address) *top soil & clay 2.5 2.5*
blue clay 200 225

(2) Location: *SW 1/4 NE 1/4, Sec. 14 T16 R1E*
4 miles *N*, of *West Point*
(distance) (direction) (Nearest Town)

Sand 15 348

(3) Topography: *Flat*
(Hilly) (Flat) (Level)

(4) Purpose of Well: *Domestic*
(Domestic Irrigation Municipal, Industrial, Other)

Information upon completion of well:

- (1) Diameter *5* inches.
- (2) Total Depth *340* feet.
- (3) Water Level *125* feet below top of ground.
- (4) Cased to *30*, Size *5"*
- (5) Screen: Size *None*, Length _____
- (6) Were any formations sealed against pollution?
Yes, _____ no.

If YES depth of formation *25'*


Why *Smiley & sand*

Drillers Remarks: _____

Yield in gpm: *3*

Size pump: *1/2*

Type power: *Electric*

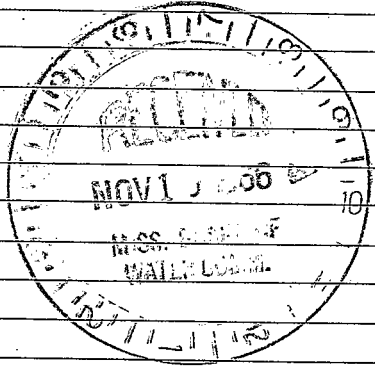

1917
1918

1919

[The remainder of the page contains extremely faint and illegible text, likely bleed-through from the reverse side of the document.]