

Monroe

O 2006

MISSISSIPPI BOARD OF WATER COMMISSIONERS

5-66

WATER WELL DRILLERS LOG

Herndon-Homan Well & Supply, Inc.

Date: May, 1966, Driller: P. O. Box 42, County Monroe, SHANNON, MISSISSIPPI 38888

(1) Owner of Land: Jim Craig (Name)

Contractor Prairie Miss (Address)

(2) Location: Center 1/4, Sec 26 T5S R6E, 3 1/2 miles SE of Prairie (distance, direction, Nearest Town)

(3) Topography: Flat (Hilly, Flat, Level)

(4) Purpose of Well: Church (Domestic Irrigation, Municipal, Industrial, Other)


Table with 3 columns: Description & Color of Materials, Thickness Feet, Depth Feet. Contains handwritten entries: Black surface soil 18, Blue clay 162, Sand 120, 300.

Information upon completion of well:

- (1) Diameter 4 inches.
(2) Total Depth 300 feet.
(3) Water Level 95 feet below top of ground.
(4) Cased to 20', Size 4"
(5) Screen: Size None, Length
(6) Were any formations sealed against pollution? yes

If YES depth of formation 14', Why surface & sand

Drillers Remarks: Yield in gpm: 3, Size pump: 3/4, Type power: Electric

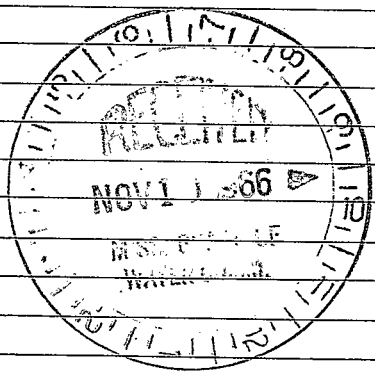

1940

1941

1942

1972