

Monroe

0 2010

9-66

MISSISSIPPI BOARD OF WATER COMMISSIONERS

WATER WELL DRILLERS LOG

Date: Sept 12, 1966, Driller: Herndon-Homan Well & Supply, Inc. Monroe
(When well drilled) P. O. Box 42 Monroe
SHANNON, MISSISSIPPI 39088 (Where well is located)


(1) Owner of Land: Neal Farms
(Name)
At Aberdeen, Miss.
(Address)
(2) Location: NE 1/4, SE 1/4, Sec. 23, T. 15 S, R. 6 E
3 miles SE of Pravie
(distance) (direction) (Nearest Town)
(3) Topography: level
(Hilly) (Flat) (Level)
(4) Purpose of Well: Domestic
(Domestic Irrigation
Municipal, Industrial, Other)

| Description & Color of Materials Sand, Clay, Red Clay, Shell, etc. | Thick- ness Feet | Depth Feet |
|---|------------------------|---------------|
| <u>surface - black</u> | | |
| <u>clay</u> | <u>20</u> | <u>20</u> |
| <u>blue clay</u> | <u>240</u> | <u>260</u> |
| <u>gravel</u> | <u>130</u> | <u>390</u> |

Information upon completion of well:

(1) Diameter 5 inches.
(2) Total Depth 390 feet.
(3) Water Level 70' feet below top of ground.
(4) Cased to 22' 6", Size 5"
(5) Screen: Size none, Length _____
(6) Were any formations sealed against pollution?
✓ yes, _____ no.

If YES depth of formation 20'
Why surface + sand
Drillers Remarks: _____
Yield in gpm: 5
Size pump: 3/4 Set
Type power: Electric

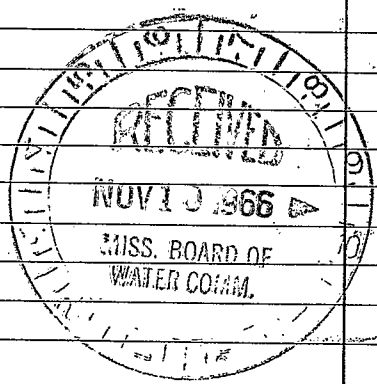

Mail this copy to Board of Water Commissioners 429 Miss. St. Jackson, Miss.

1911

1912

1913

1939