

~~MONROE~~
 0211
 11-66

MISSISSIPPI
 BOARD OF WATER COMMISSIONERS
 416 North State Street
 Jackson, Mississippi 39201
 WATER WELL DRILLERS LOG

Nov. 20 1966 Herndon-Homan Well & Supply, Monroe
 date well completed firm name Box 12 county well located
 STANNON, MISSISSIPPI 39368


LANDOWNER:
 Martin Townsend
 Rt. 3 West Point Miss.
 (mailing address)

description of formations encountered	from	to
surface sand & clay	0	28'
blue clay	28'	340'
green clay	340'	360'
bottom	360'	

WELL LOCATION:
 sec. 17 T. 6 N. R. 6 E.
 S. W.
 3 miles SW of Mulden
 (distance) (direction) (nearest town)

WELL PURPOSE: Home
 (home, irrigation, municipal, industrial)

- WELL COMPLETION DATA:
- (1) diameter (inches) 4"
 - (2) total depth (feet) 360'
 - (3) static water level (feet) 60' below top of ground.
 - (4) casing steel 31' 9" (material) (depth)
 40 (size) if telescope see back.
 - (5) screen none (length) (depth to top)
 (size) (material)
 - (6) pump HP (HP) (yield gpm)
 (type power)
 - (7) electric log no (yes or no)
 (organization running log)
 - (8) how well bottom plugged open

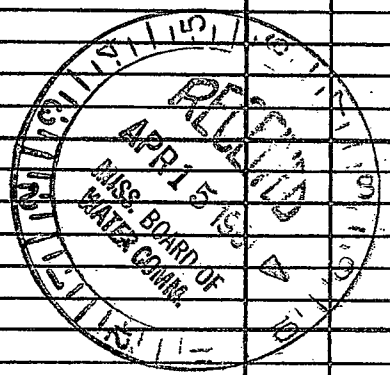

DRILLERS REMARKS:

If well telescopes please sketch and show depths.

GROUND LEVEL

		X	

SECTION 17

Please indicate well location X.

ADDITIONAL INFORMATION

If more than one screen, show locations of each on sketch.