

MONROE
 O 212
 1-67

MISSISSIPPI
 BOARD OF WATER COMMISSIONERS
 416 North State Street
 Jackson, Mississippi 39201

WATER WELL DRILLERS LOG

1-10 1967 W.J. REEVES & SON MONROE
 date well completed firm name county well located

LANDOWNER: T. J. METCALFE

description of formations encountered	from	to
BLACK SOIL	0	4
YELLOW CLAY	4	9
BLUE CLAY	9	247
BLUE SAND	247	270
BLUE CLAY	270	308
BLUE SAND	308	320
BLUE CLAY	320	328
" SAND	328	341
" CLAY	341	346
" SAND	346	421


ABERDEEN, MISS
 (mailing address)

WELL LOCATION:
 sec. 17 T. 15 S. R. 10 E
 10 miles SW of ABERDEEN
 (distance) (direction) (nearest town)

WELL PURPOSE: HOME
 (home, irrigation, municipal, industrial)

WELL COMPLETION DATA:


- (1) diameter (inches) 4
- (2) total depth (feet) 421
- (3) static water level (feet) 97 below top of ground.
- (4) casing STEEL, 21' (material) (depth)
 (size) if telescope see back.
- (5) screen NONE (length) (depth to top)
 (size) (material)
- (6) pump NONE (HP) (yield gpm)
 (type power)
- (7) electric log No (yes or no)
 (organization running log)
- (8) how well bottom plugged OPEN

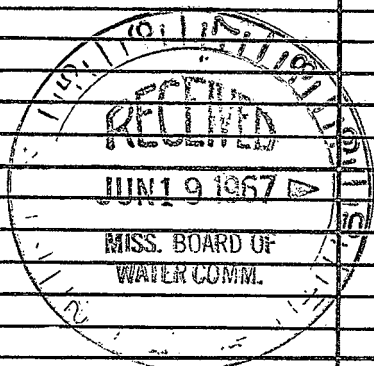

DRILLERS REMARKS:

If well telescopes please sketch and show depths.

GROUND LEVEL

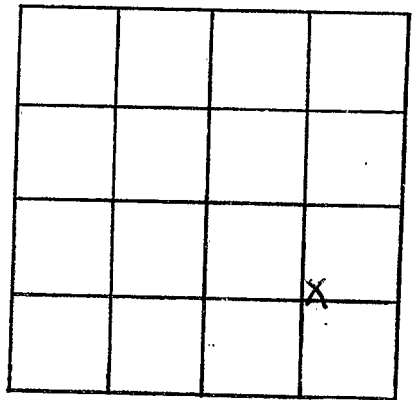

SECTION 17

Please indicate well location X.

ADDITIONAL INFORMATION

If more than one screen,
show locations of each on sketch.