

**MISSISSIPPI
BOARD OF WATER COMMISSIONERS**
416 North State Street
Jackson, Mississippi 39201

WATER WELL DRILLERS LOG

Monroe
07013
3-67

3-24 1967 W. J. REEVES & SON MONROE
date well completed firm name county well located

LANDOWNER: N. C. COOK

description of formations encountered

from to

RT. 1

PRAIRIE

(mailing address)

WELL LOCATION:

sec. 17 T. 15 S. R. 6 E. #
10 miles SW of ABERDEEN
(distance) (direction) (nearest town)

WELL PURPOSE: HOME
(home, irrigation, municipal, industrial)

WELL COMPLETION DATA:

(1) diameter (inches) 4

(2) total depth (feet) 1397

(3) static water level (feet) 115 below top of ground.

(4) casing STEEL, 21'
(material) (depth)

4" if telescope see back.
(size)

(5) screen NONE
(length) (depth to top)

(size) (material)

(6) pump NONE
(HP) (yield gpm)

(type power)


(7) electric log NO
(yes or no)

(organization running log)

(8) how well bottom plugged OPEN


<u>BURCK SOIL</u>	<u>0</u>	<u>3</u>
<u>YELLOW CLAY</u>	<u>3</u>	<u>13</u>
<u>BLUE CLAY</u>	<u>13</u>	<u>216</u>
<u>1" SAND</u>	<u>216</u>	<u>224</u>
<u>1" CLAY</u>	<u>224</u>	<u>261</u>
<u>1" SAND</u>	<u>261</u>	<u>283</u>
<u>1" CLAY</u>	<u>283</u>	<u>321</u>
<u>1" SAND</u>	<u>321</u>	<u>367</u>
<u>BLUE CLAY & SAND</u>	<u>367</u>	<u>397</u>

DRILLERS REMARKS:

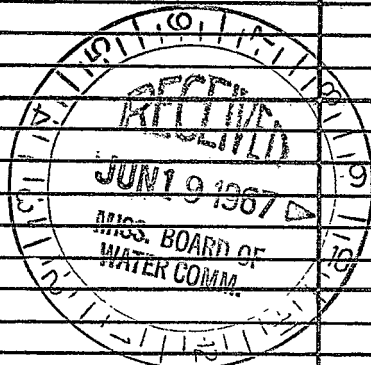

If well telescopes please sketch and show depths.

GROUND LEVEL

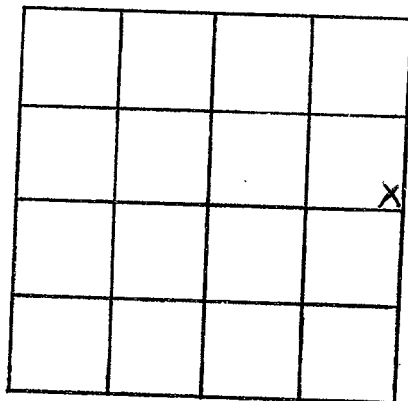

SECTION _____

Please indicate well location X.

ADDITIONAL INFORMATION

If more than one screen, show locations of each on sketch.