

MONROE
 O 2016
 9-67

MISSISSIPPI
 BOARD OF WATER COMMISSIONERS
 416 North State Street
 Jackson, Mississippi 39201

WATER WELL DRILLERS LOG

9/15 19 67 Merndon-Homan Well & Supply, Inc. MONROE
 date well completed firm, on Box 42 county well located
 BEAUNON, MISSISSIPPI 38868

LANDOWNER:

A. A. Schoock
 Prairie Mills
 (mailing address)

description of formations encountered

from to

surface soil	0	33
Clay	33	280
Blue clay	280	400
Sand	400	
Bottom		

WELL LOCATION:

sec. 17 T. 15 N. R. 6 E.
2 miles SW of Prairie
 (distance) (direction) (nearest town)


WELL PURPOSE:

Home
 (home, irrigation, municipal, industrial)

WELL COMPLETION DATA:


- diameter (inches) 5"
- total depth (feet) 400'
- static water level (feet) 95' below top of ground.
- casing Steel, 35' (material) (depth)
 (size) if telescope see back.
- screen none (length) (depth to top)
 (size) (material)
- pump 70 (HP) 10 (yield gpm)
electric (type power)
- electric log no (yes or no)
 (organization running log)
- how well bottom plugged open

DRILLERS REMARKS:

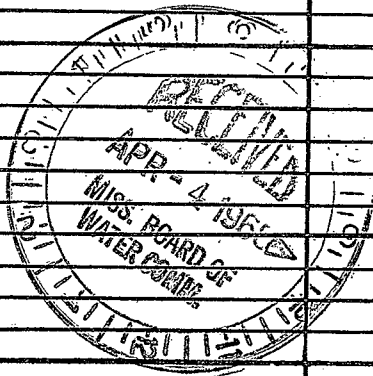

If well telescopes please sketch and show depths.

GROUND LEVEL

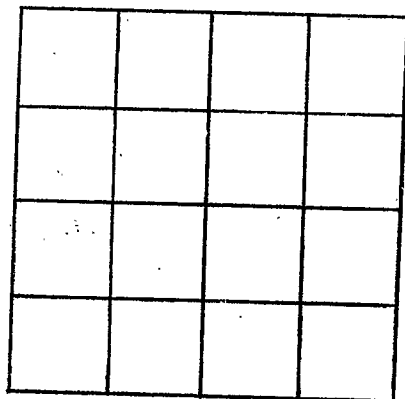

SECTION _____

Please indicate well location X.

ADDITIONAL INFORMATION

If more than one screen, show locations of each on sketch.