

MONROE  
 O 2017  
 10-67

MISSISSIPPI  
 BOARD OF WATER COMMISSIONERS  
 416 North State Street  
 Jackson, Mississippi 39201

WATER WELL DRILLERS LOG

10/25  
 date/well completed

19 67 Monroe-Homan Well & Supply, Inc. Monroe  
 firm name Box 42  
 SHANNON, MISSISSIPPI 38850 county well located

LANDOWNER:

Henry Townsend  
West Point, Miss  
 (mailing address)

description of formations encountered

from to

<u>surface sand &amp; clay</u>	<u>0</u>	<u>50</u>
<u>Blue clay</u>	<u>30</u>	<u>240</u>
<u>Sand</u>	<u>240</u>	<u>360</u>
<u>Both</u>	<u>360</u>	

WELL LOCATION:

sec. 17 T. 16 N. R. 6 E  
S  
5 miles NW of West Point  
 (distance) (direction) (nearest town)


WELL PURPOSE:

Home  
 (home, irrigation, municipal, industrial)

WELL COMPLETION DATA:


- diameter (inches) 4"
- total depth (feet) 360'
- static water level (feet) 82' below top of ground.
- casing steel, 3 3/4" (material), (depth)
- RD if telescope see back. (size)
- screen none (length), (depth to top)
- (size), (material)
- pump HP (HP), (yield gpm)
- (type power)
- electric log no (yes or no)
- (organization running log)
- how well bottom plugged open

DRILLERS REMARKS:

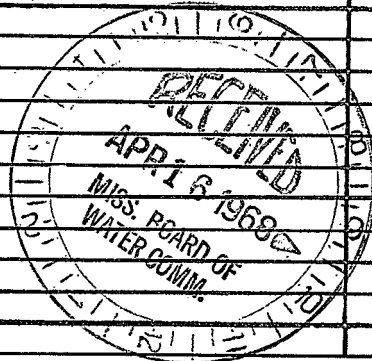

If well telescopes please sketch and show depths.

GROUND LEVEL

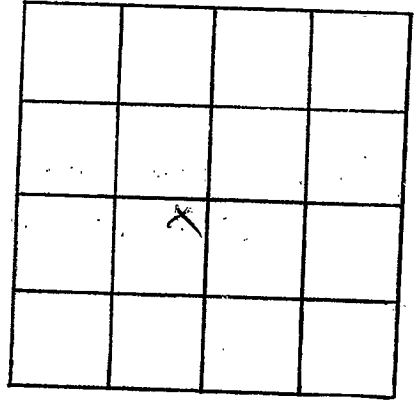

SECTION 17

Please indicate well location X.

ADDITIONAL INFORMATION

If more than one screen, show locations of each on sketch.