

MONROE
 O 2018
 11-67

MISSISSIPPI
 BOARD OF WATER COMMISSIONERS
 416 North State Street
 Jackson, Mississippi 39201

WATER WELL DRILLERS LOG

11/1 19 67 Herndon-Homan Well & Supply Inc. *Almond*
 date well completed firm name box 42 county well located

LANDOWNER:
NATHANIEL ROX
West Point
 (mailing address)

description of formations encountered	from	to
<i>Surface sand & clay</i>	<i>0</i>	<i>38</i>
<i>Blue clay</i>	<i>38</i>	<i>270</i>
<i>Sand</i>	<i>270</i>	<i>360</i>
<i>Bottom</i>	<i>360</i>	

WELL LOCATION:
 sec 5 T 16 N R 6 E
 S
2 1/2 miles SW of Waldora
 (distance) (direction) (nearest town)

WELL PURPOSE:
 (home, irrigation, municipal, industrial) *Home*


- WELL COMPLETION DATA:
- (1) diameter (inches) 5"
 - (2) total depth (feet) 360'
 - (3) static water level (feet) 80 below above top of ground.
 - (4) casing Steel, 40'
 (material) (depth)
 _____ if telescope see back.
 (size)
 - (5) screen wire
 (length) (depth to top)

 (size) (material)
 - (6) pump no _____
 (HP) (yield gpm)

 (type power)
 - (7) electric log no
 (yes or no)


 (organization running log)
 - (8) how well bottom plugged open

DRILLERS REMARKS:

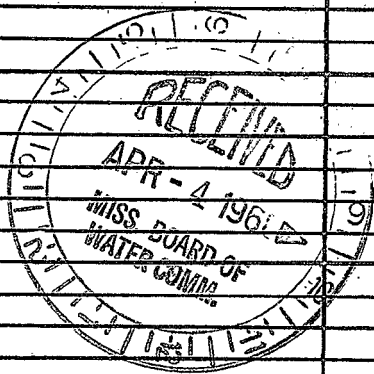

If well telescopes please sketch and show depths.

GROUND LEVEL

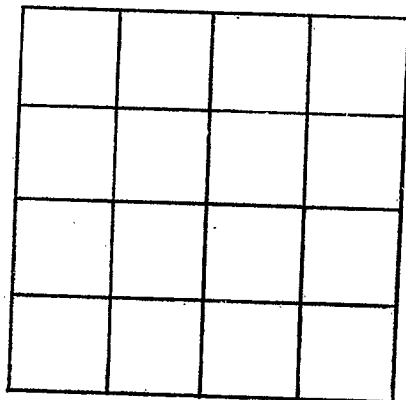

SECTION _____

Please indicate well location X.

ADDITIONAL INFORMATION

If more than one screen,
show locations of each on sketch.