

Monroe  
 0 2019  
 7-68

MISSISSIPPI  
 BOARD OF WATER COMMISSIONERS  
 416 North State Street  
 Jackson, Mississippi 39201

WATER WELL DRILLERS LOG

Herndon-Homan Well & Supply, Inc

7-2 19 <sup>68</sup> P.O. Box 42 Monroe  
 date well completed SELANTON, MISSISSIPPI county well located


LANDOWNER:  
R. W. Greaves  
P.O. Box 296 Aberdeen  
 (mailing address) MISS

description of formations encountered	from	to
<u>Surface sand</u>	<u>0</u>	<u>18</u>
<u>+ clay</u>	<u>18</u>	<u>260</u>
<u>Sand</u>	<u>260</u>	<u>380</u>
<u>Bottom</u>	<u>380</u>	

WELL LOCATION:  
 sec. 34 T 15 N R. 6 E  
1/4 miles S of Madison  
 (distance) (direction) (nearest town)

WELL PURPOSE: Home  
 (home, irrigation, municipal, industrial)


- WELL COMPLETION DATA:
- (1) diameter (inches) 5"
  - (2) total depth (feet) 380'
  - (3) static water level (feet) 24' below top of ground.
  - (4) casing Steel, 326" (material) (depth)  
5" (size) if telescope see back.
  - (5) screen NO (length) (depth to top)  
           (size) (material)
  - (6) pump B<sub>1</sub> 5th (HP) (yield gpm)  
           (type power)
  - (7) electric log NO (yes or no)  
           (organization running log)
  - (8) how well bottom plugged open

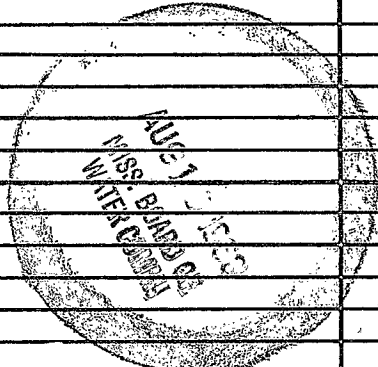

DRILLERS REMARKS:

If well telescopes please sketch and show depths.

GROUND LEVEL

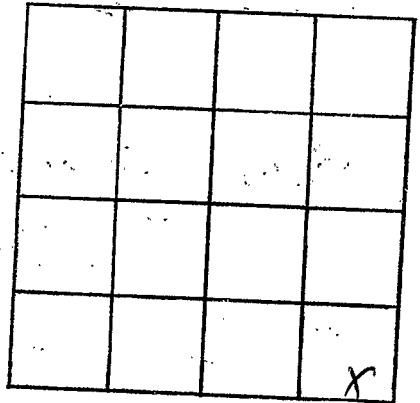

SECTION 34

Please indicate well location X.

ADDITIONAL INFORMATION

If more than one screen, show locations of each on sketch.