

Monroe  
 O 2020  
 7-68

MISSISSIPPI  
 BOARD OF WATER COMMISSIONERS  
 416 North State Street  
 Jackson, Mississippi 39201

WATER WELL DRILLERS LOG

Hernon-Homan Well & Supply, *Monroe*

date well completed 7-3 1968  
 firm name Box 42  
 county well located SEANNON, MISSISSIPPI 39966


LANDOWNER:  
 Mrs. A. C. Rogers  
 P.O. Box 296, Aberdeen  
 (mailing address) MSR

description of formations encountered	from	to
Surface sand	0	18
clay	18	200
blue clay sand	200	250
Blue	350	

WELL LOCATION:  
 sec. 39 T. 15 N R. 6 E  
 S W  
 1/4 miles S of Mulder  
 (distance) (direction) (nearest town)

WELL PURPOSE: Home  
 (home, irrigation, municipal, industrial)


- WELL COMPLETION DATA:
- (1) diameter (inches) 8 1/2"
  - (2) total depth (feet) 380'
  - (3) static water level (feet) 124' below top of ground.
  - (4) casing steep 22' (material), (depth)
  - 5" if telescope see back.
  - (5) screen 20' (length), (depth to top)
  - (size) (material)
  - (6) pump 1/2 HP 200 (yield gpm)
  - (type power)
  - (7) electric log NO (yes or no)
  - (organization running log)
  - (8) how well bottom plugged Open

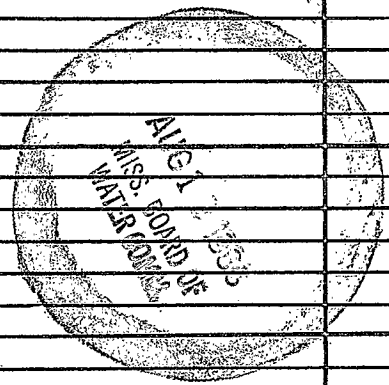

DRILLERS REMARKS:

If well telescopes please sketch and show depths.

GROUND LEVEL

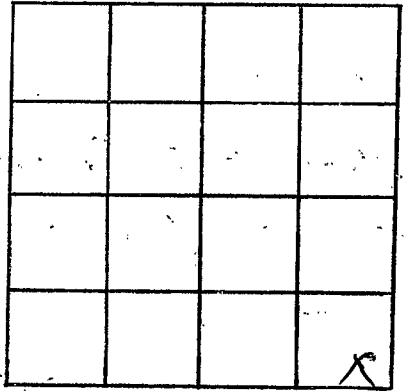

SECTION 34

Please indicate well location X.

ADDITIONAL INFORMATION

If more than one screen,  
show locations of each on sketch.